


EXISTING



existing wall location wall to be removed.

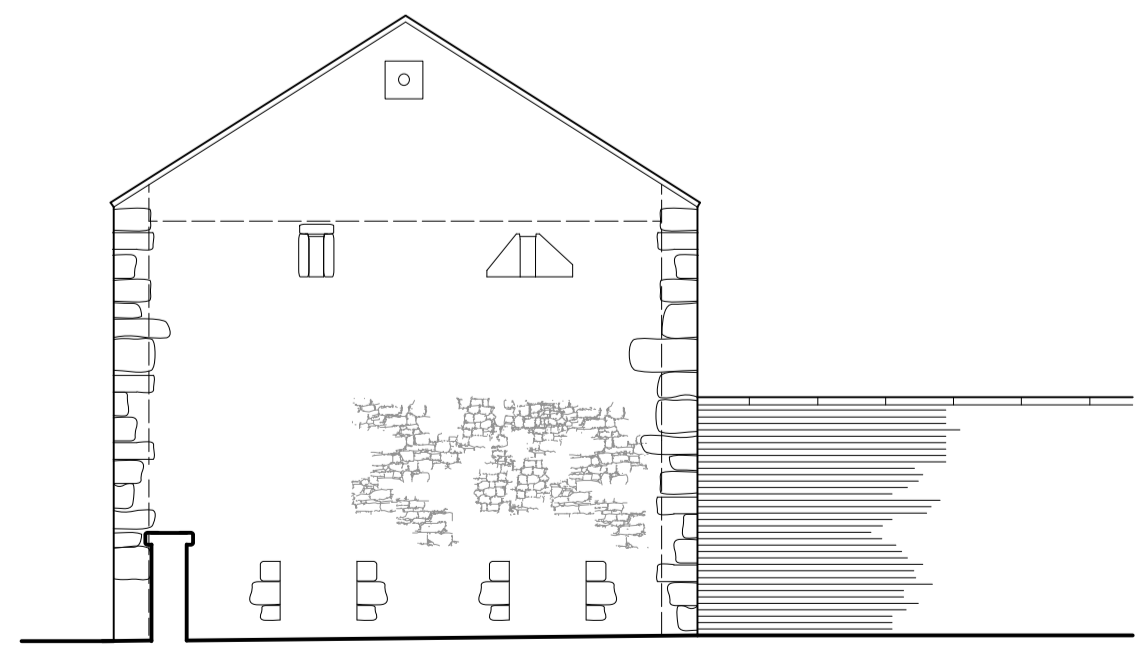

existing floor removed



Rev : A 14/11/23 - Minor amendments to commentary to suit final design
Issue -

FOR PLANNING

Client -
Sella Park Country House Hotel
Project -
New Residential Bedrooms
Location / Postcode / what3words
Sella Park, Calderbridge
cases.yacht.forgotten

Drawing Title - Structural Mark Up
Job No - 1377 Dwg No - 06 Rev : A
DATE : 1Feb 2023 SCALE : 1: 50 Paper A1



E - greenswallow@btinternet.com
M - 07970 96 41 84
Registered Office : Green Swallow North Limited,
Swallow Barn, Blindcrake, Cumbria, CA13 0QP
ALL DIMENSIONS TO BE CHECKED ON SITE
FIGURED DIMENSIONS TO BE TAKEN IN PREFERENCE
TO SCALED DIMENSIONS
copyright Green Swallow North Limited