


NOTES

- All dimensions and levels are to be checked on site.
- Any discrepancies are to be reported to the architect before any work commences.
- This drawing shall not be used to ascertain any dimensions, work to fixed items only.
- This drawing shall not be reproduced without express written permission from AEW.
- Title, drawing, drawings and ownership boundaries are the responsibility of the architect and shall not be responsible for the accuracy or scale discrepancy of base plans supplied to them.
- All works are to be undertaken in accordance with Building Regulations and the latest British Standards.
- All proprietary materials and products are to be used strictly in accordance with the manufacturers recommendations.

CDM 2015

Client notified of duties: **At Design Workshops**
Principal Designer: **CS3**
Unless noted below, all known hazards have been highlighted on the drawing:

Notes:
All drawings to be read in conjunction with all other drawings as noted on issue sheet.

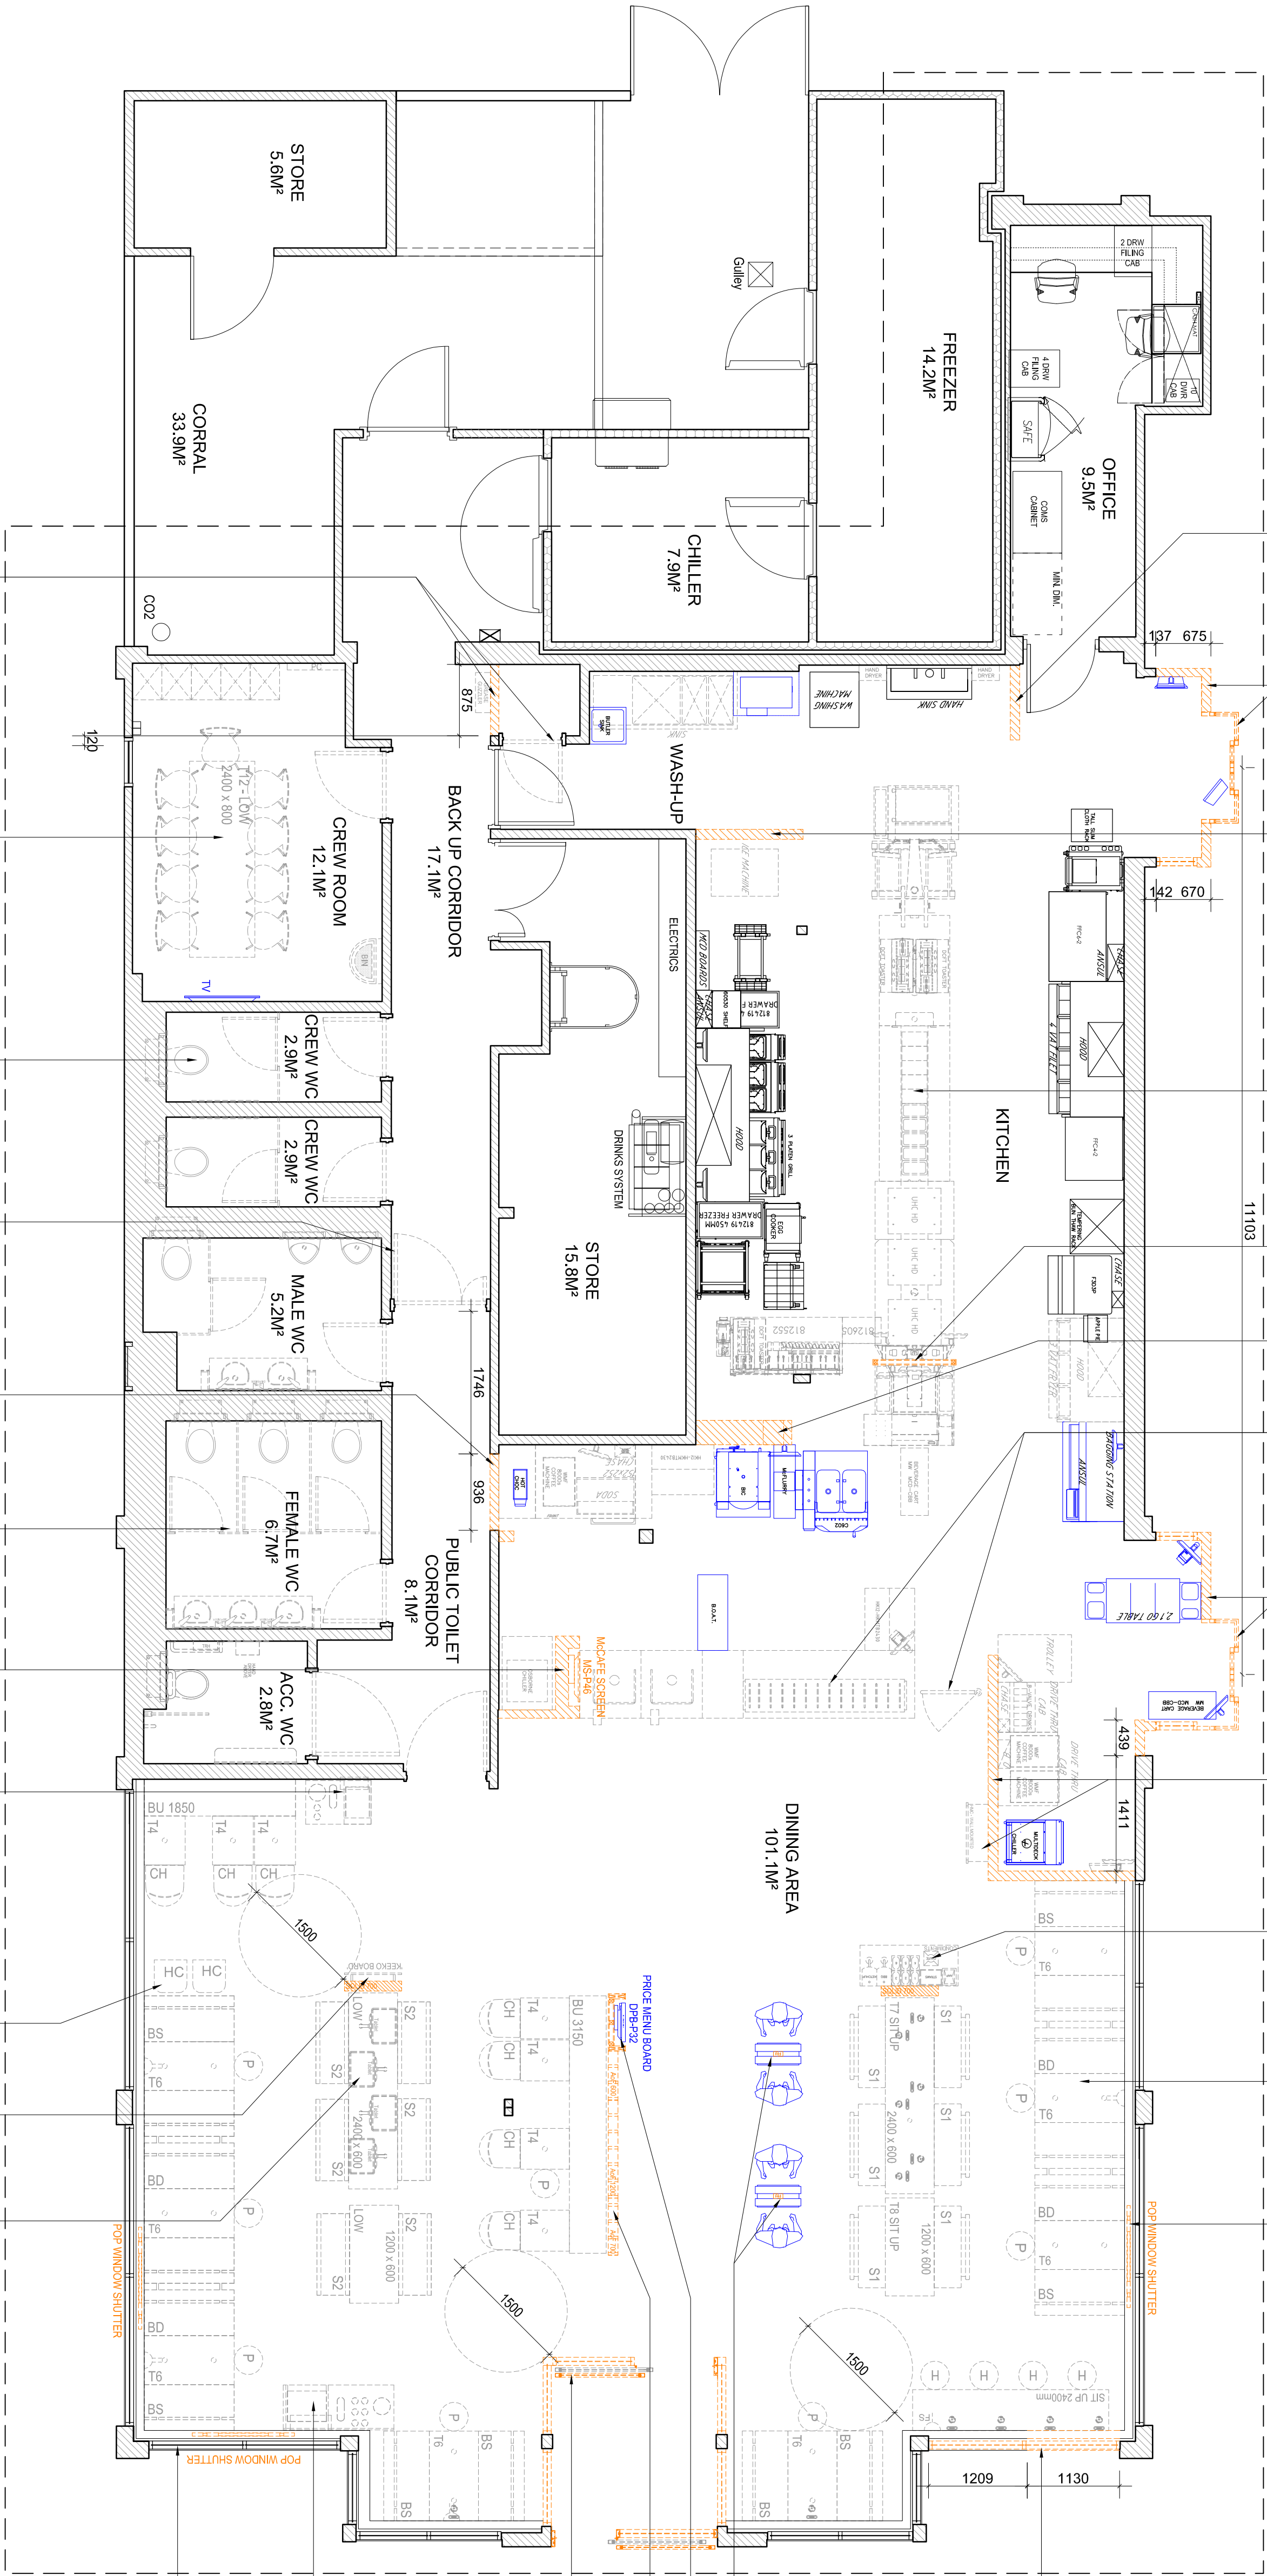

- EXISTING DOOR TO BE REMOVED, APERTURE TO BE CREATED IN EXISTING WALL
- EXISTING DOORS, CUBICLES & SANITARYWARE IN CREW ROOM TO BE REMOVED, EXISTING TV UNIT TO BE RELOCATED
- EXISTING DOORS, CUBICLES & SANITARYWARE IN CREW WCs TO BE REMOVED, EXISTING TV UNIT TO BE RELOCATED
- EXISTING DOORS TO BACK UP CORRIDOR TO BE REMOVED, EXISTING TV UNIT TO BE RELOCATED
- APERTURE TO BE CREATED IN EXISTING WALL
- EXISTING CUBICLES & SANITARYWARE IN PUBLIC TOILET CORRIDOR TO BE REMOVED, DOORS TO BE REDECORATED
- EXISTING WALL & MOBILE SCREEN TO BE REMOVED
- EXISTING MINI RECYCLING UNIT TO BE REMOVED
- EXISTING HIGH CHAIRS TO BE REMOVED
- EXISTING KERO TO BE REMOVED
- EXISTING TABLETS TO BE REMOVED

AREAS SCHEDULE	
TOTAL COVERS	82
DINING AREA INTERNAL AREA (m²)	101.1m²
WC INTERNAL AREA (m²)	14.7m²
CREW ROOM INTERNAL AREA (m²)	12.1m²

DRAWINGS BASED ON:
AS BUILT 03/09/08, 0060, H
H&K DIN-XXXX WHITEHAVEN - BRIDGES
RETAIL PARK - GBR - COIT-REV A

IRLX & REIMAGE GEOMETRY

project	BRIDGES RETAIL PARK WHITEHAVEN	stage	0098
drawing title	EXISTING GA PLAN	scale	1:50
date	03/04/24	drawn	HN
checked	MW		
client	McDonald's Restaurants Ltd		
Status	Purpose of Issue	Checked by:-	
S2	For Information		
drawing stage	STAGE 1		

EXISTING GENERAL ARRANGEMENT PLAN 1:50