





AS BUILT WEST SOUTH WEST ELEVATION 1-50

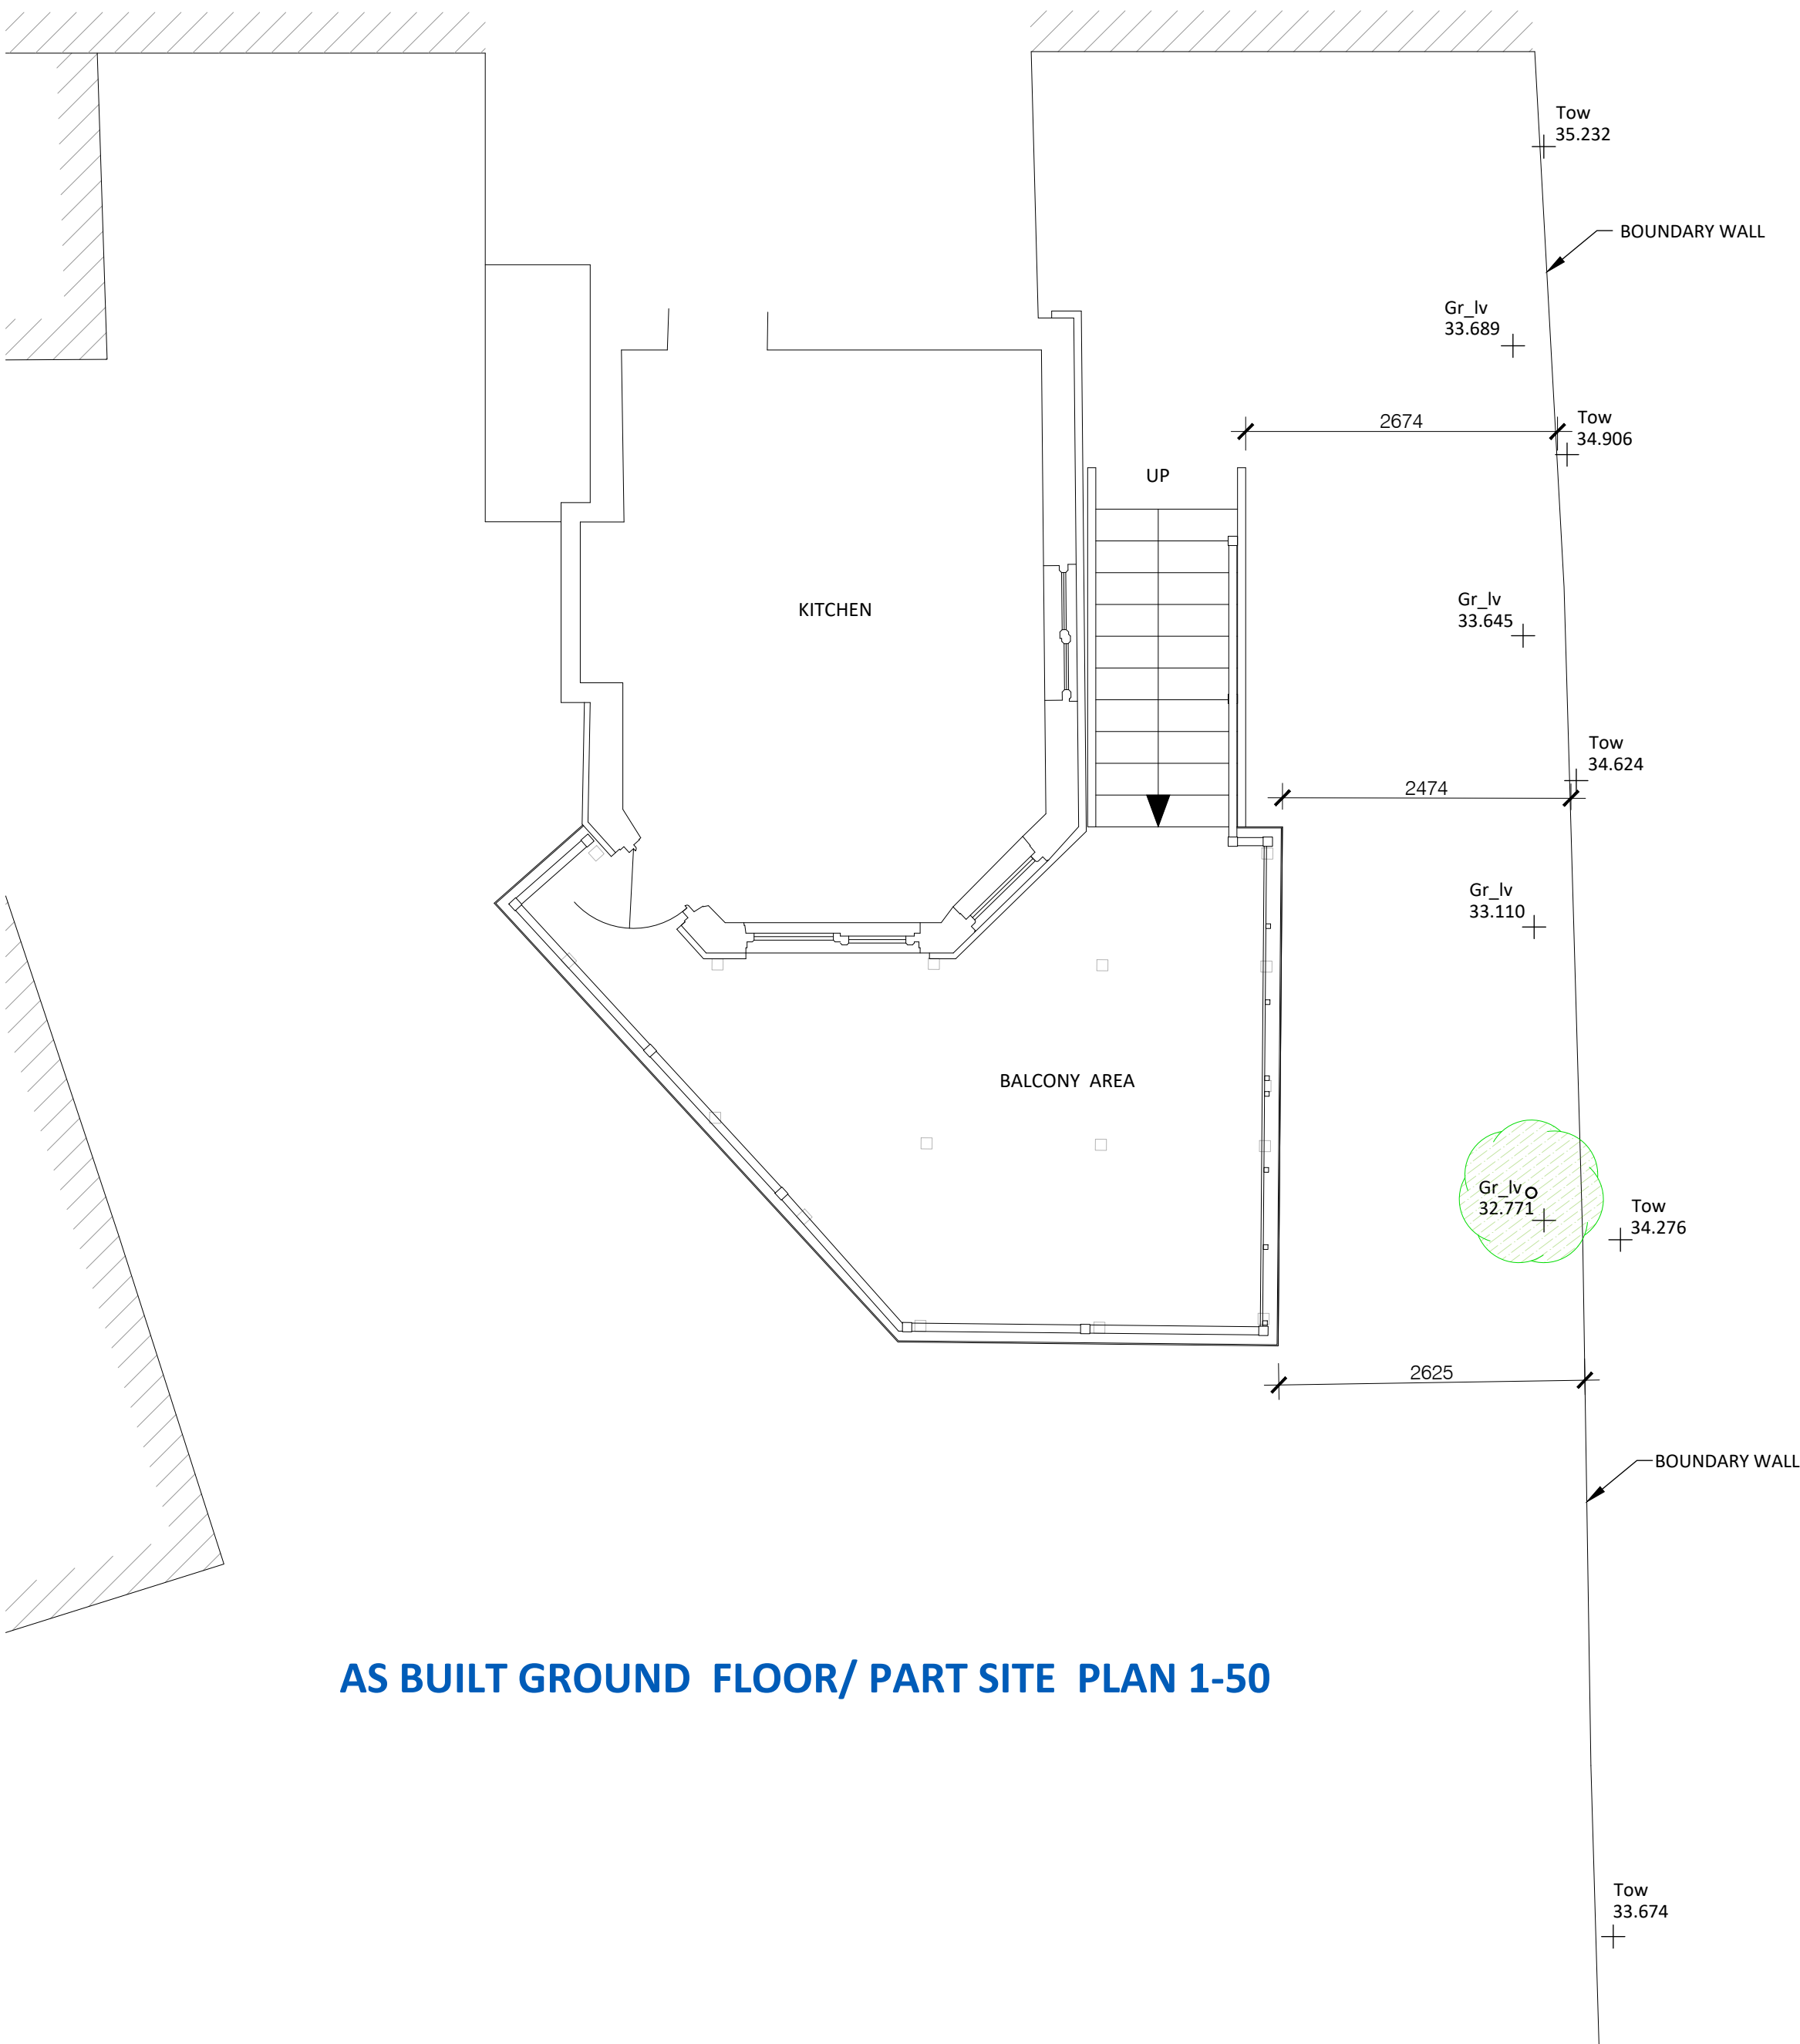

AS BUILT GROUND FLOOR/ PART SITE PLAN 1-50



AS BUILT NORTH NORTH WEST ELEVATION 1-50

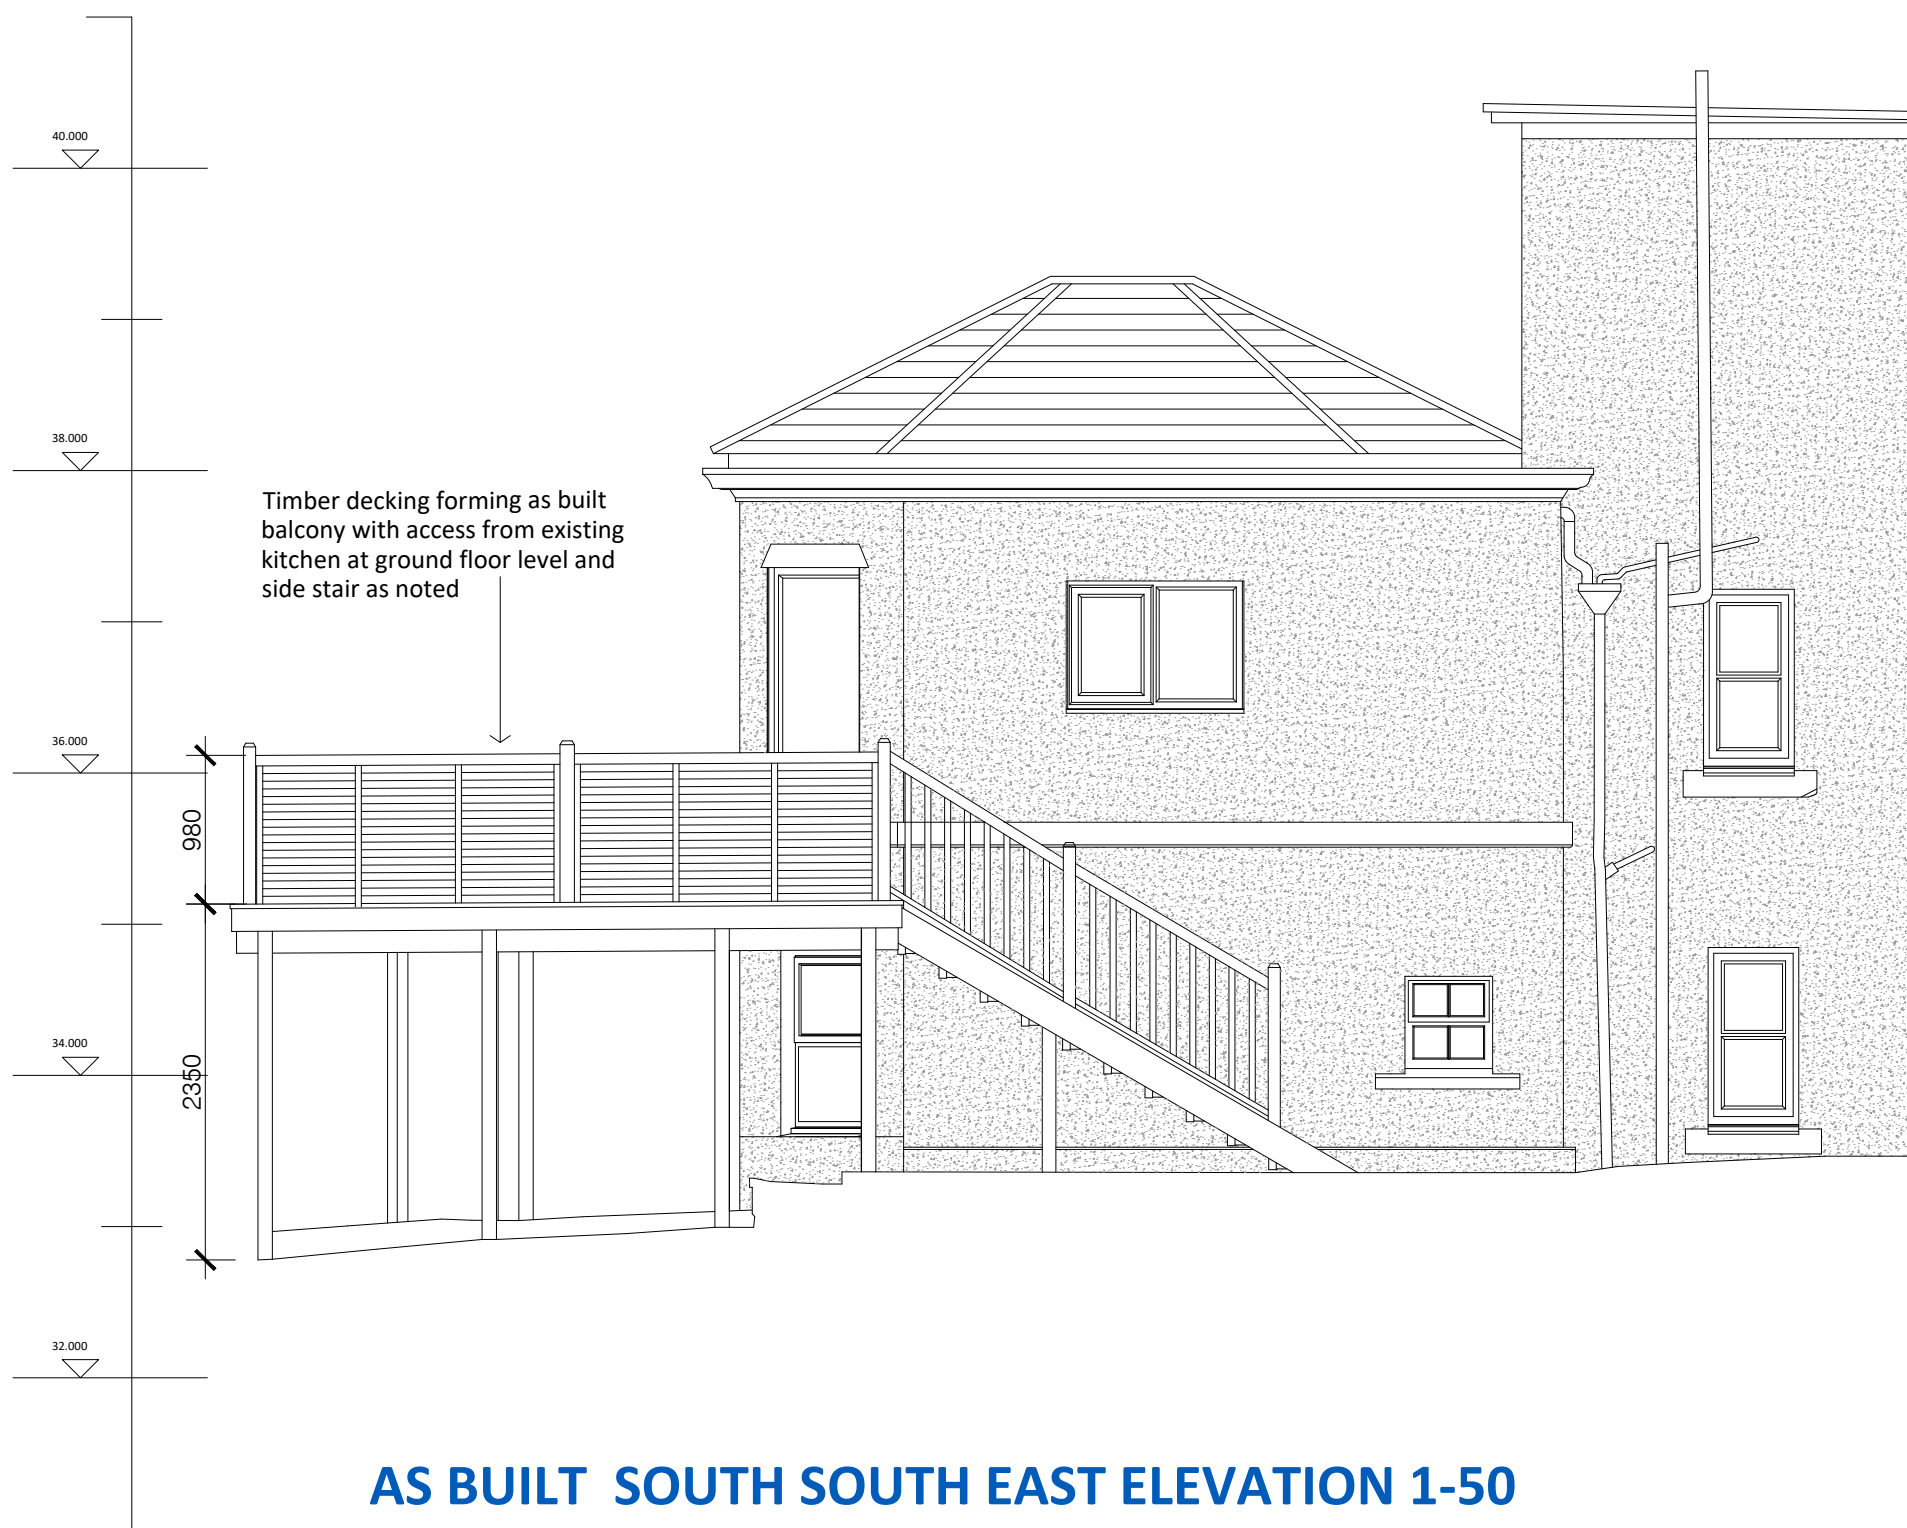

AS BUILT SOUTH SOUTH EAST ELEVATION 1-50



Revisions	Description	Date

swarbrick
associates (uk) ltd

CHARTERED ARCHITECTS
40 Aglionby Street Carlisle CA1 1JP

Tel : 01228 595552
E Mail : info@swarbrickassociates.co.uk
Website : www.swarbrickassociates.co.uk

No 2 Laurel Bank, Foxhouse Rd
Whitehaven

CLIENT:
Mr T Fisher

PROJECT:
Retrospective Planning Application for New
Timber Balcony

DRAWING:
As Built Floor / Site Plan and Elevations

DRG NO: 1964.02 rev.

Scale: 1-50 at A1 Date: June 2026