






Proposed Front Elevation (Church Lane) - (North-North-West)
Scale 1:100 @ A3

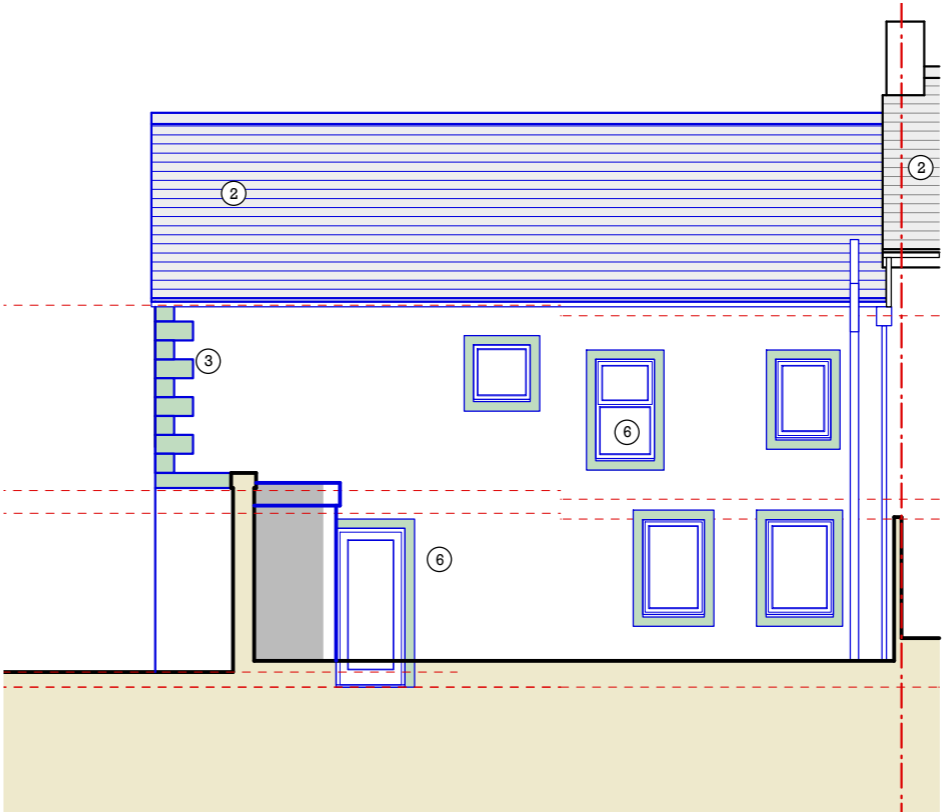

Proposed Rear Elevation (South-South East)
Scale 1:100 @ A3

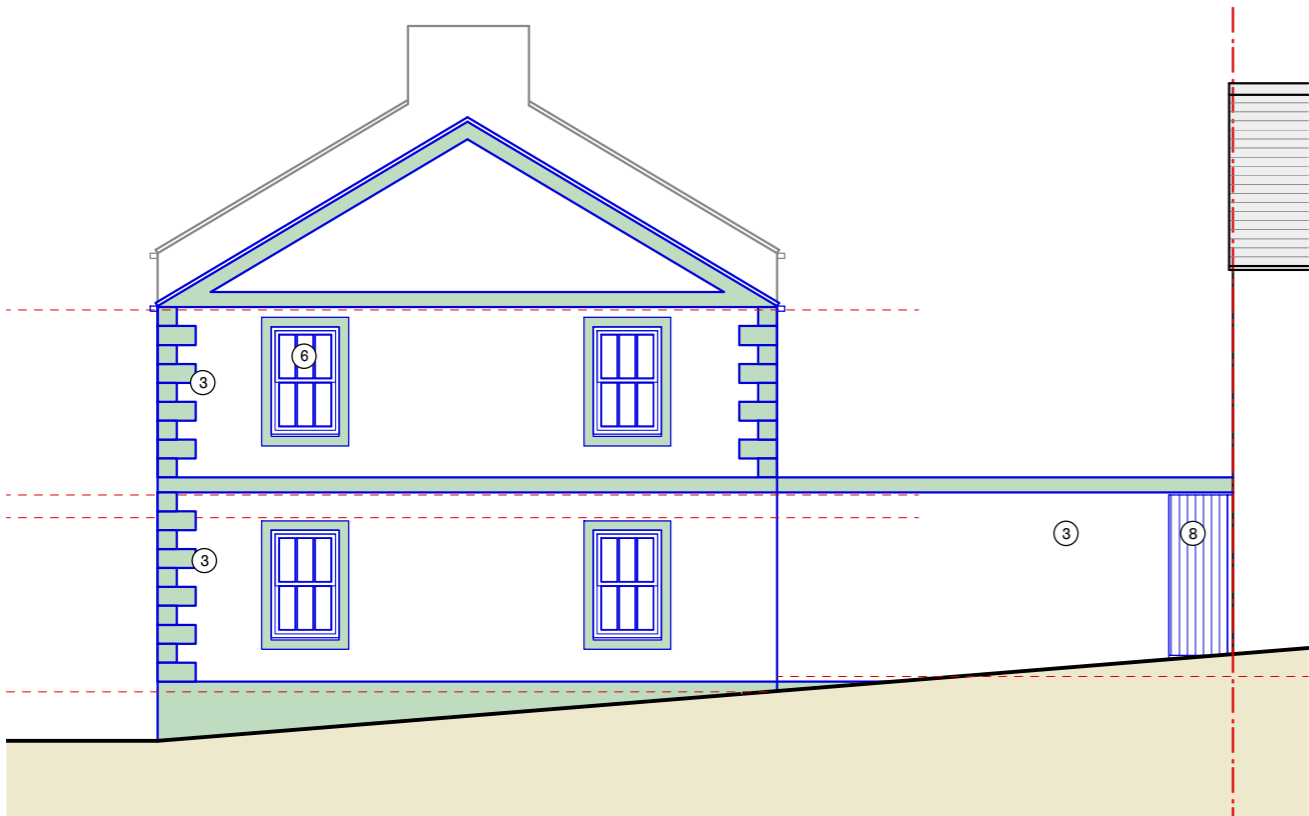


Proposed Side Elevation (Main Street) - (South- South-West)
Scale 1:100 @ A3

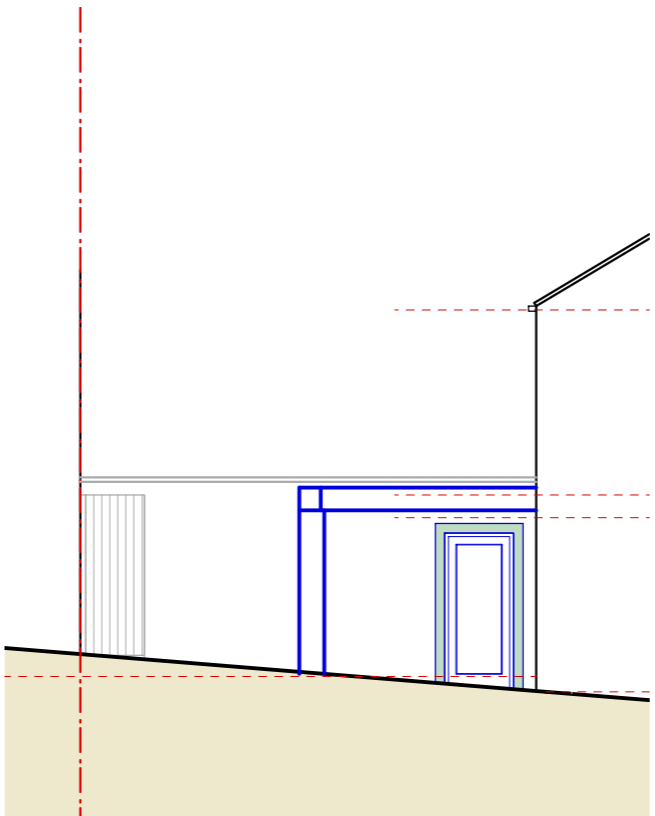

Proposed Side Elevation (Yard) - (North- North-East)
Scale 1:100 @ A3

Please Note:
Drawings subject to relevant statutory approvals.
All dimensions to be checked on site. Do not scale from this drawing. Work to figured dimensions only.
© This drawing is copyright of MC Architecture + Design Ltd and may not be reproduced in any way without their specific permission.

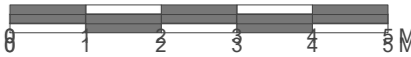

- (1) ~~Slate Rooftiles~~
- (2) Concrete Rooftiles
- (3) Painted Cement Render
- (4) ~~Slate Tile Cladding~~
- (5) ~~Wet Dash Render With Stone~~
- (6) White UPVC Window/ Doors
- (7) ~~Stained Timber Window/ Doors~~
- (8) Timber Access Gate

MCA
MC Architecture + Design

<input type="checkbox"/> Preliminary	<input type="checkbox"/> Tender
<input type="checkbox"/> For Approval	<input type="checkbox"/> Construction

Client >
GR Property Developers Ltd

Project >
5 & 6 Church Lane, Hensingham,
Whitehaven, Cumbria, CA28 8RQ.

Drawing Title >
Proposed Elevations

Scale > 1:100 @ A3	Date > Mar 2025
-----------------------	--------------------

Drawing No. > 2425-002-07	Rev > C
------------------------------	------------