




KIOSK ROOF PLAN
(SCALE 1 : 50)

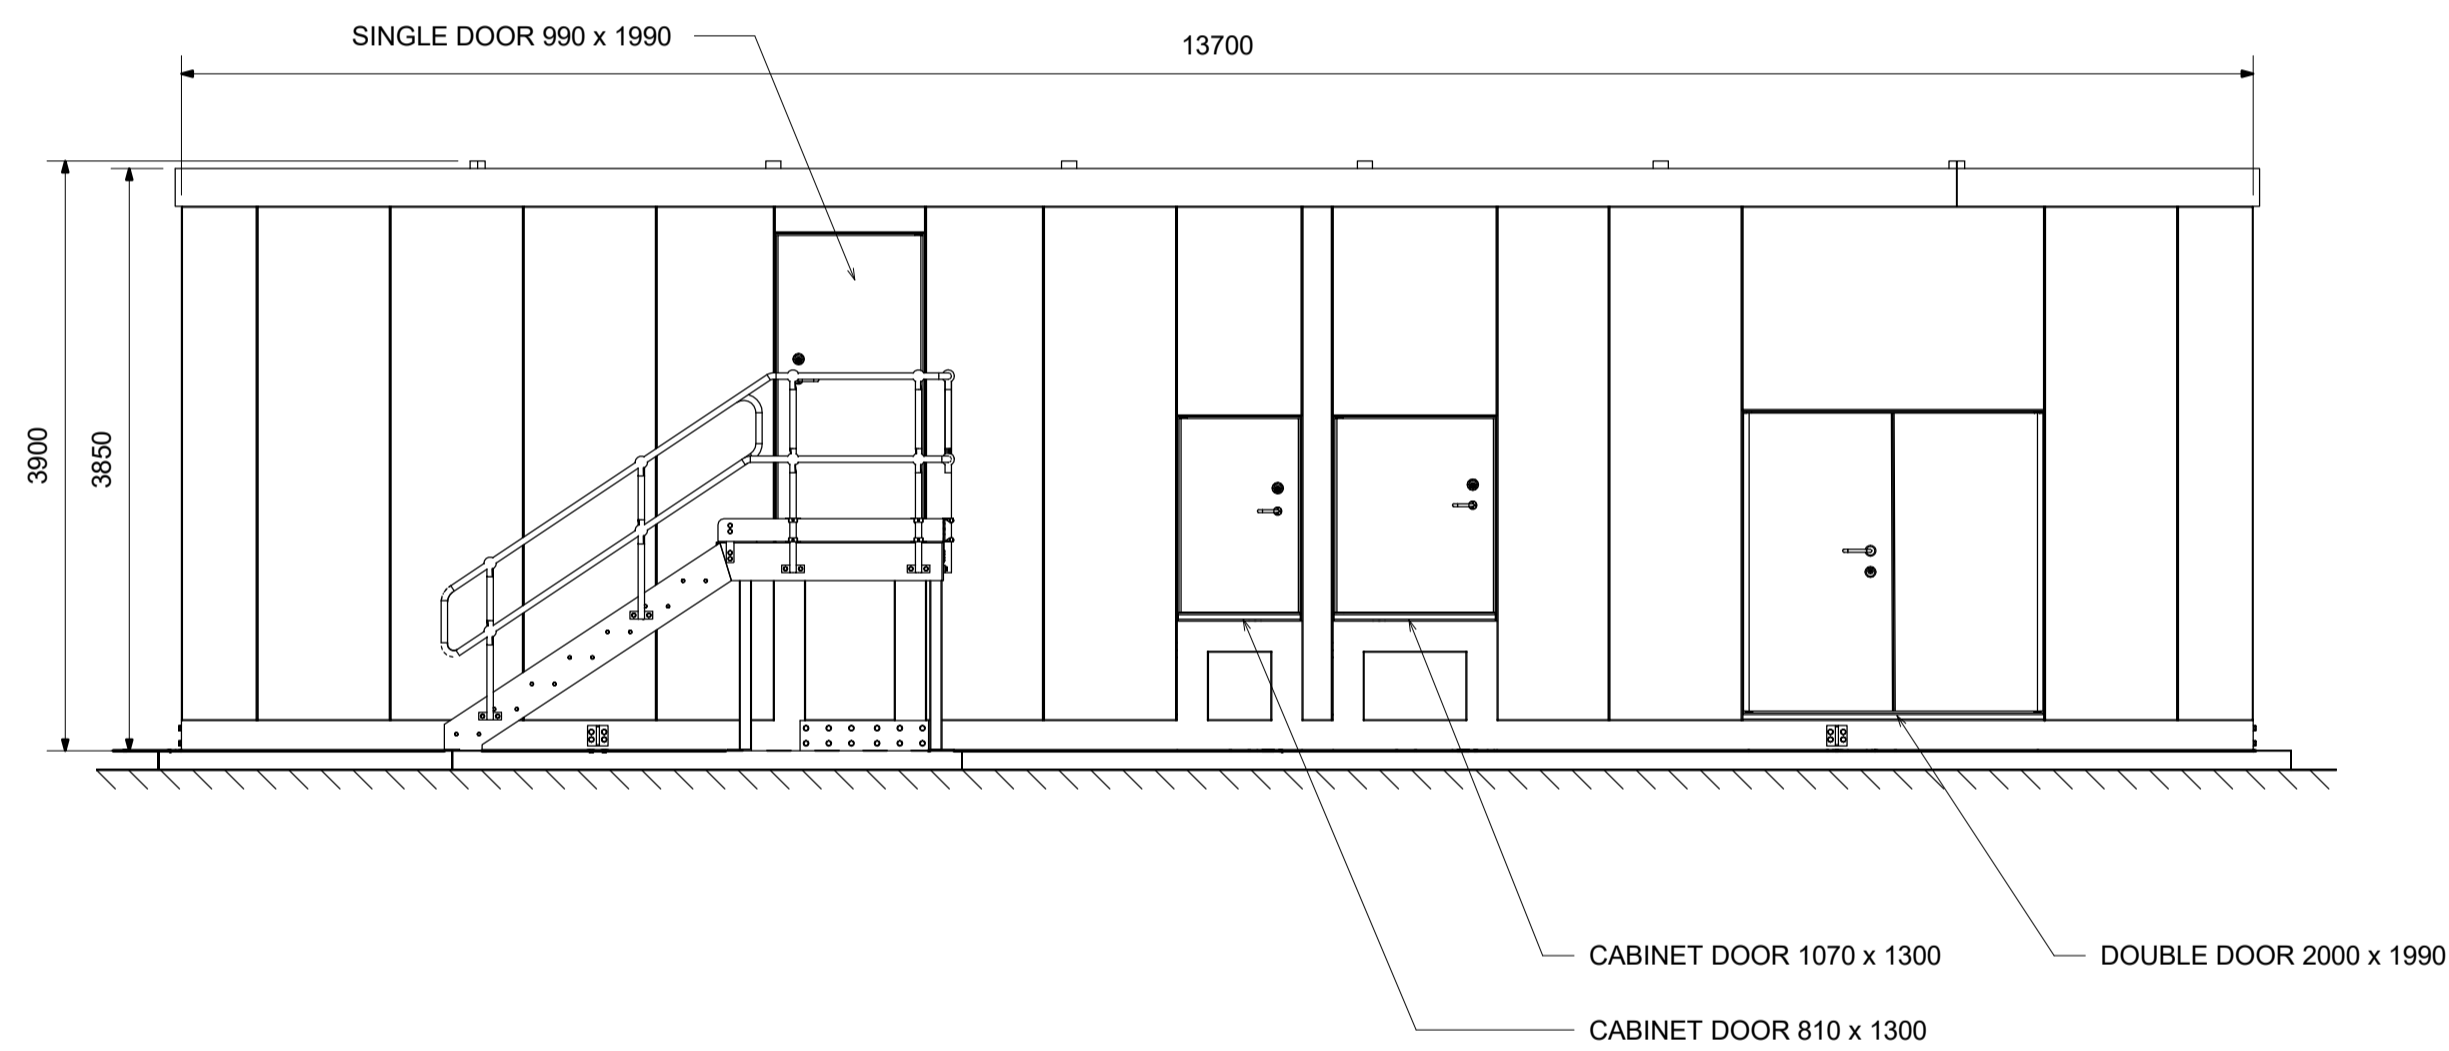


KIOSK FRONT ELEVATION - A
(SCALE 1 : 50)

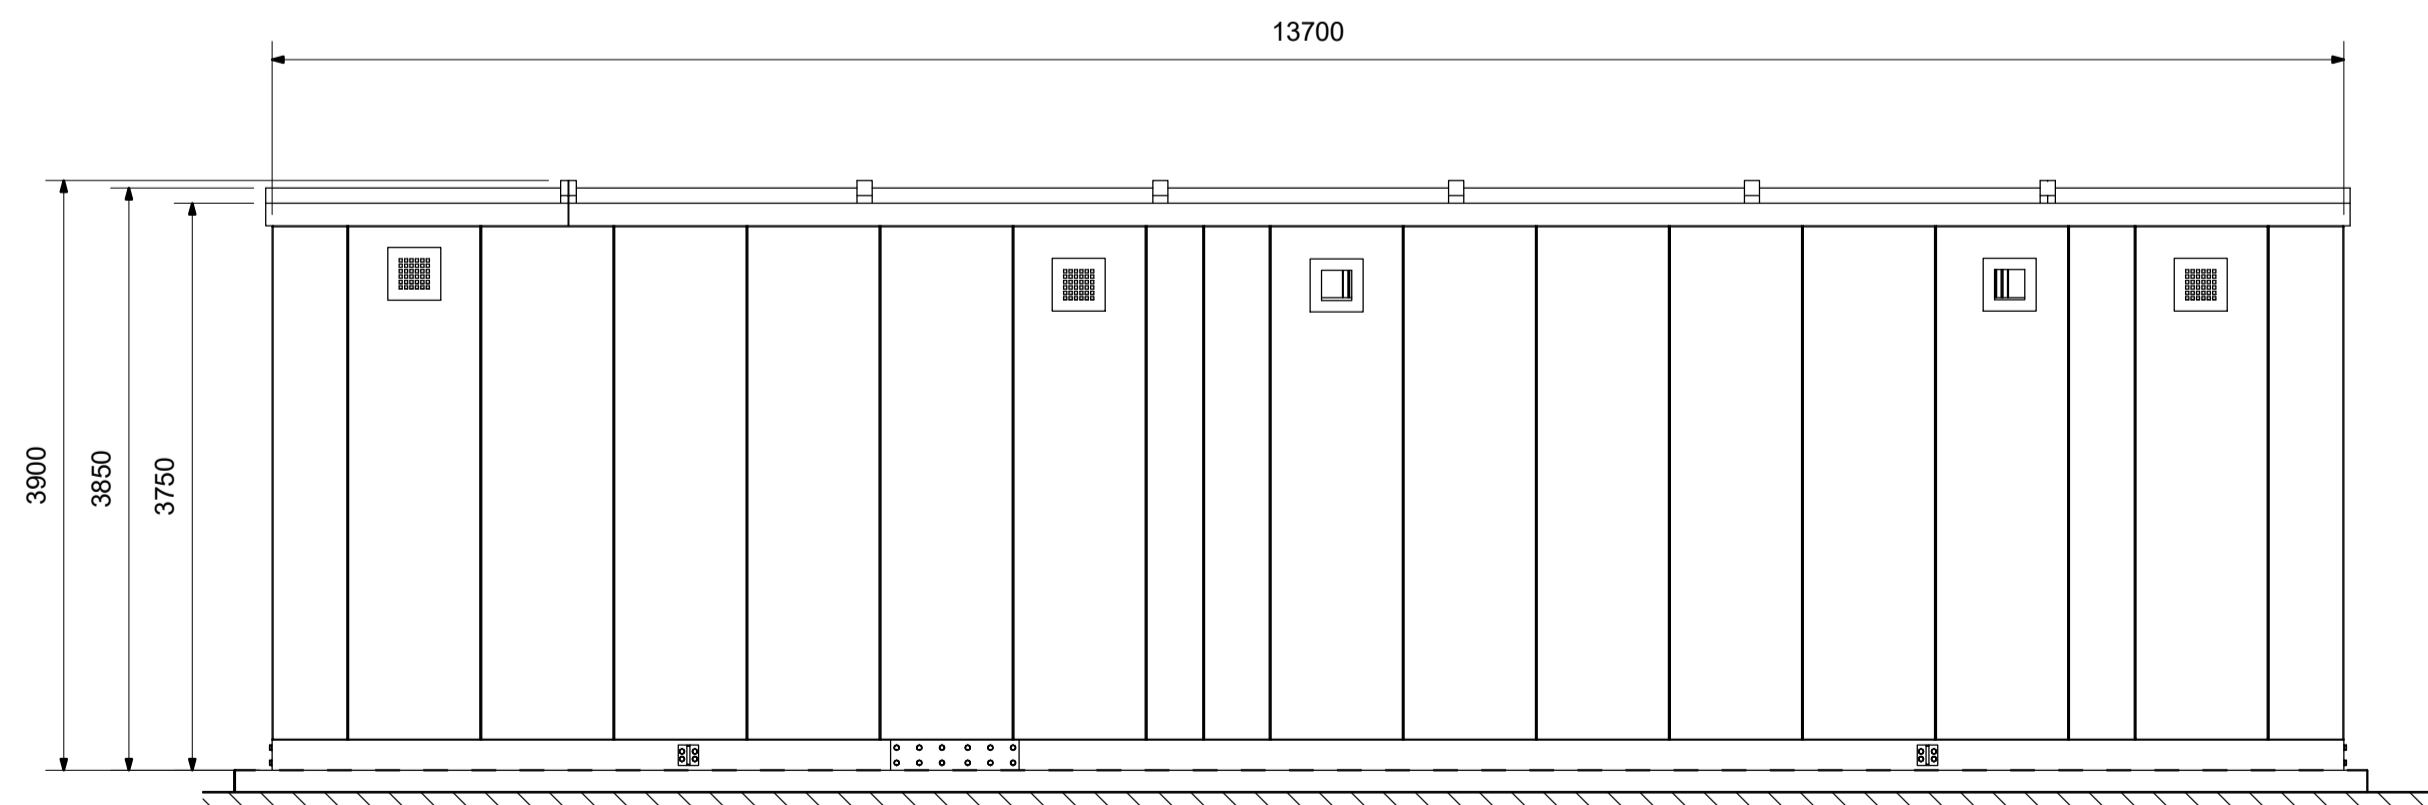

KIOSK REAR ELEVATION - C
(SCALE 1 : 50)

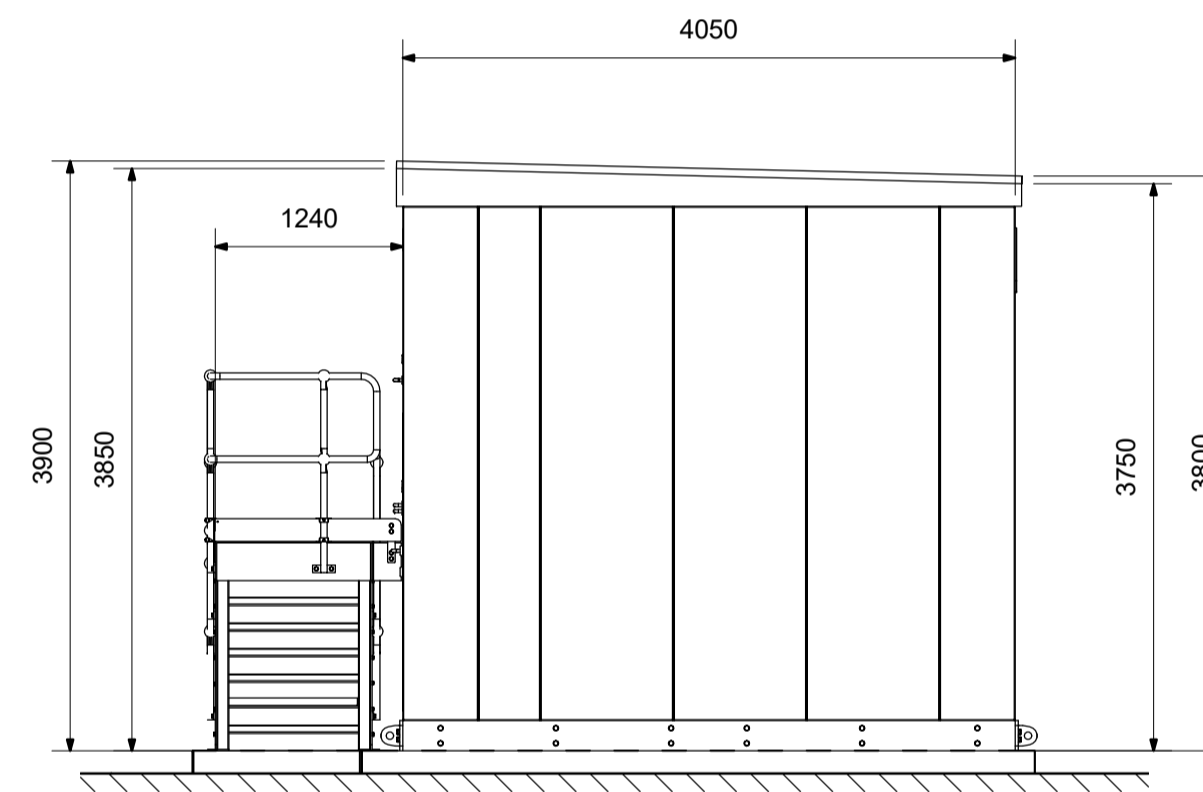



KIOSK LEFT ELEVATION - B
(SCALE 1 : 50)

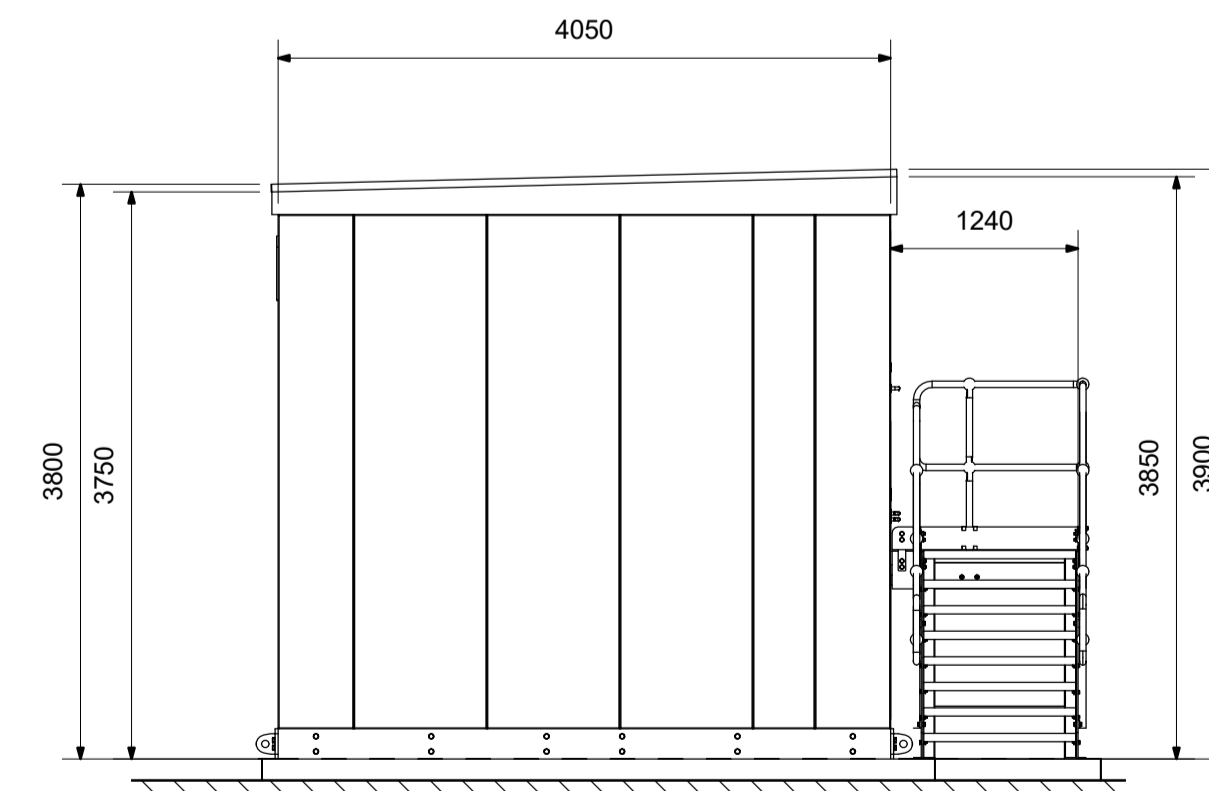

KIOSK RIGHT ELEVATION - D
(SCALE 1 : 50)

NOTES

1. ALL DIMENSIONS ARE IN MILLIMETRES. ALL LEVELS ARE IN METRES UNLESS OTHERWISE NOTED
2. THIS DRAWING IS INTENDED FOR PLANNING PURPOSES AND MUST NOT BE USED FOR CONSTRUCTION.
3. ALL DIMENSIONS ARE INDICATIVE ONLY, AND MAY BE SUBJECT TO CHANGE.
4. STEEL KIOSK - EXTERNAL COLOUR RAL 7015 (SLATE GREY) WITH MATT FINISH.

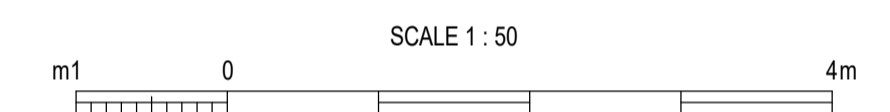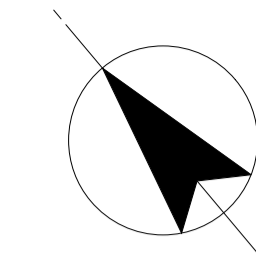

Current Issue Information

VERSION	P07	RLC	MJ	DM	ISSUED FOR PLANNING	30/10/2023
					REASON FOR ISSUE	DATE
	S2				Issued For Information	
					SUITABILITY CODE	SUITABILITY DESCRIPTION



WCSP ENHANCED ENABLING WORKS
HIGH LEYS SR
AS-BUILT DOSING KIOSK
PLANNING APPLICATION

SCALE	1 : 50	SHEET SIZE	A1
DRAWING NUMBER	80063041-01-ADP-HIGHL-97-DR-T-00001	REVISION	P07