
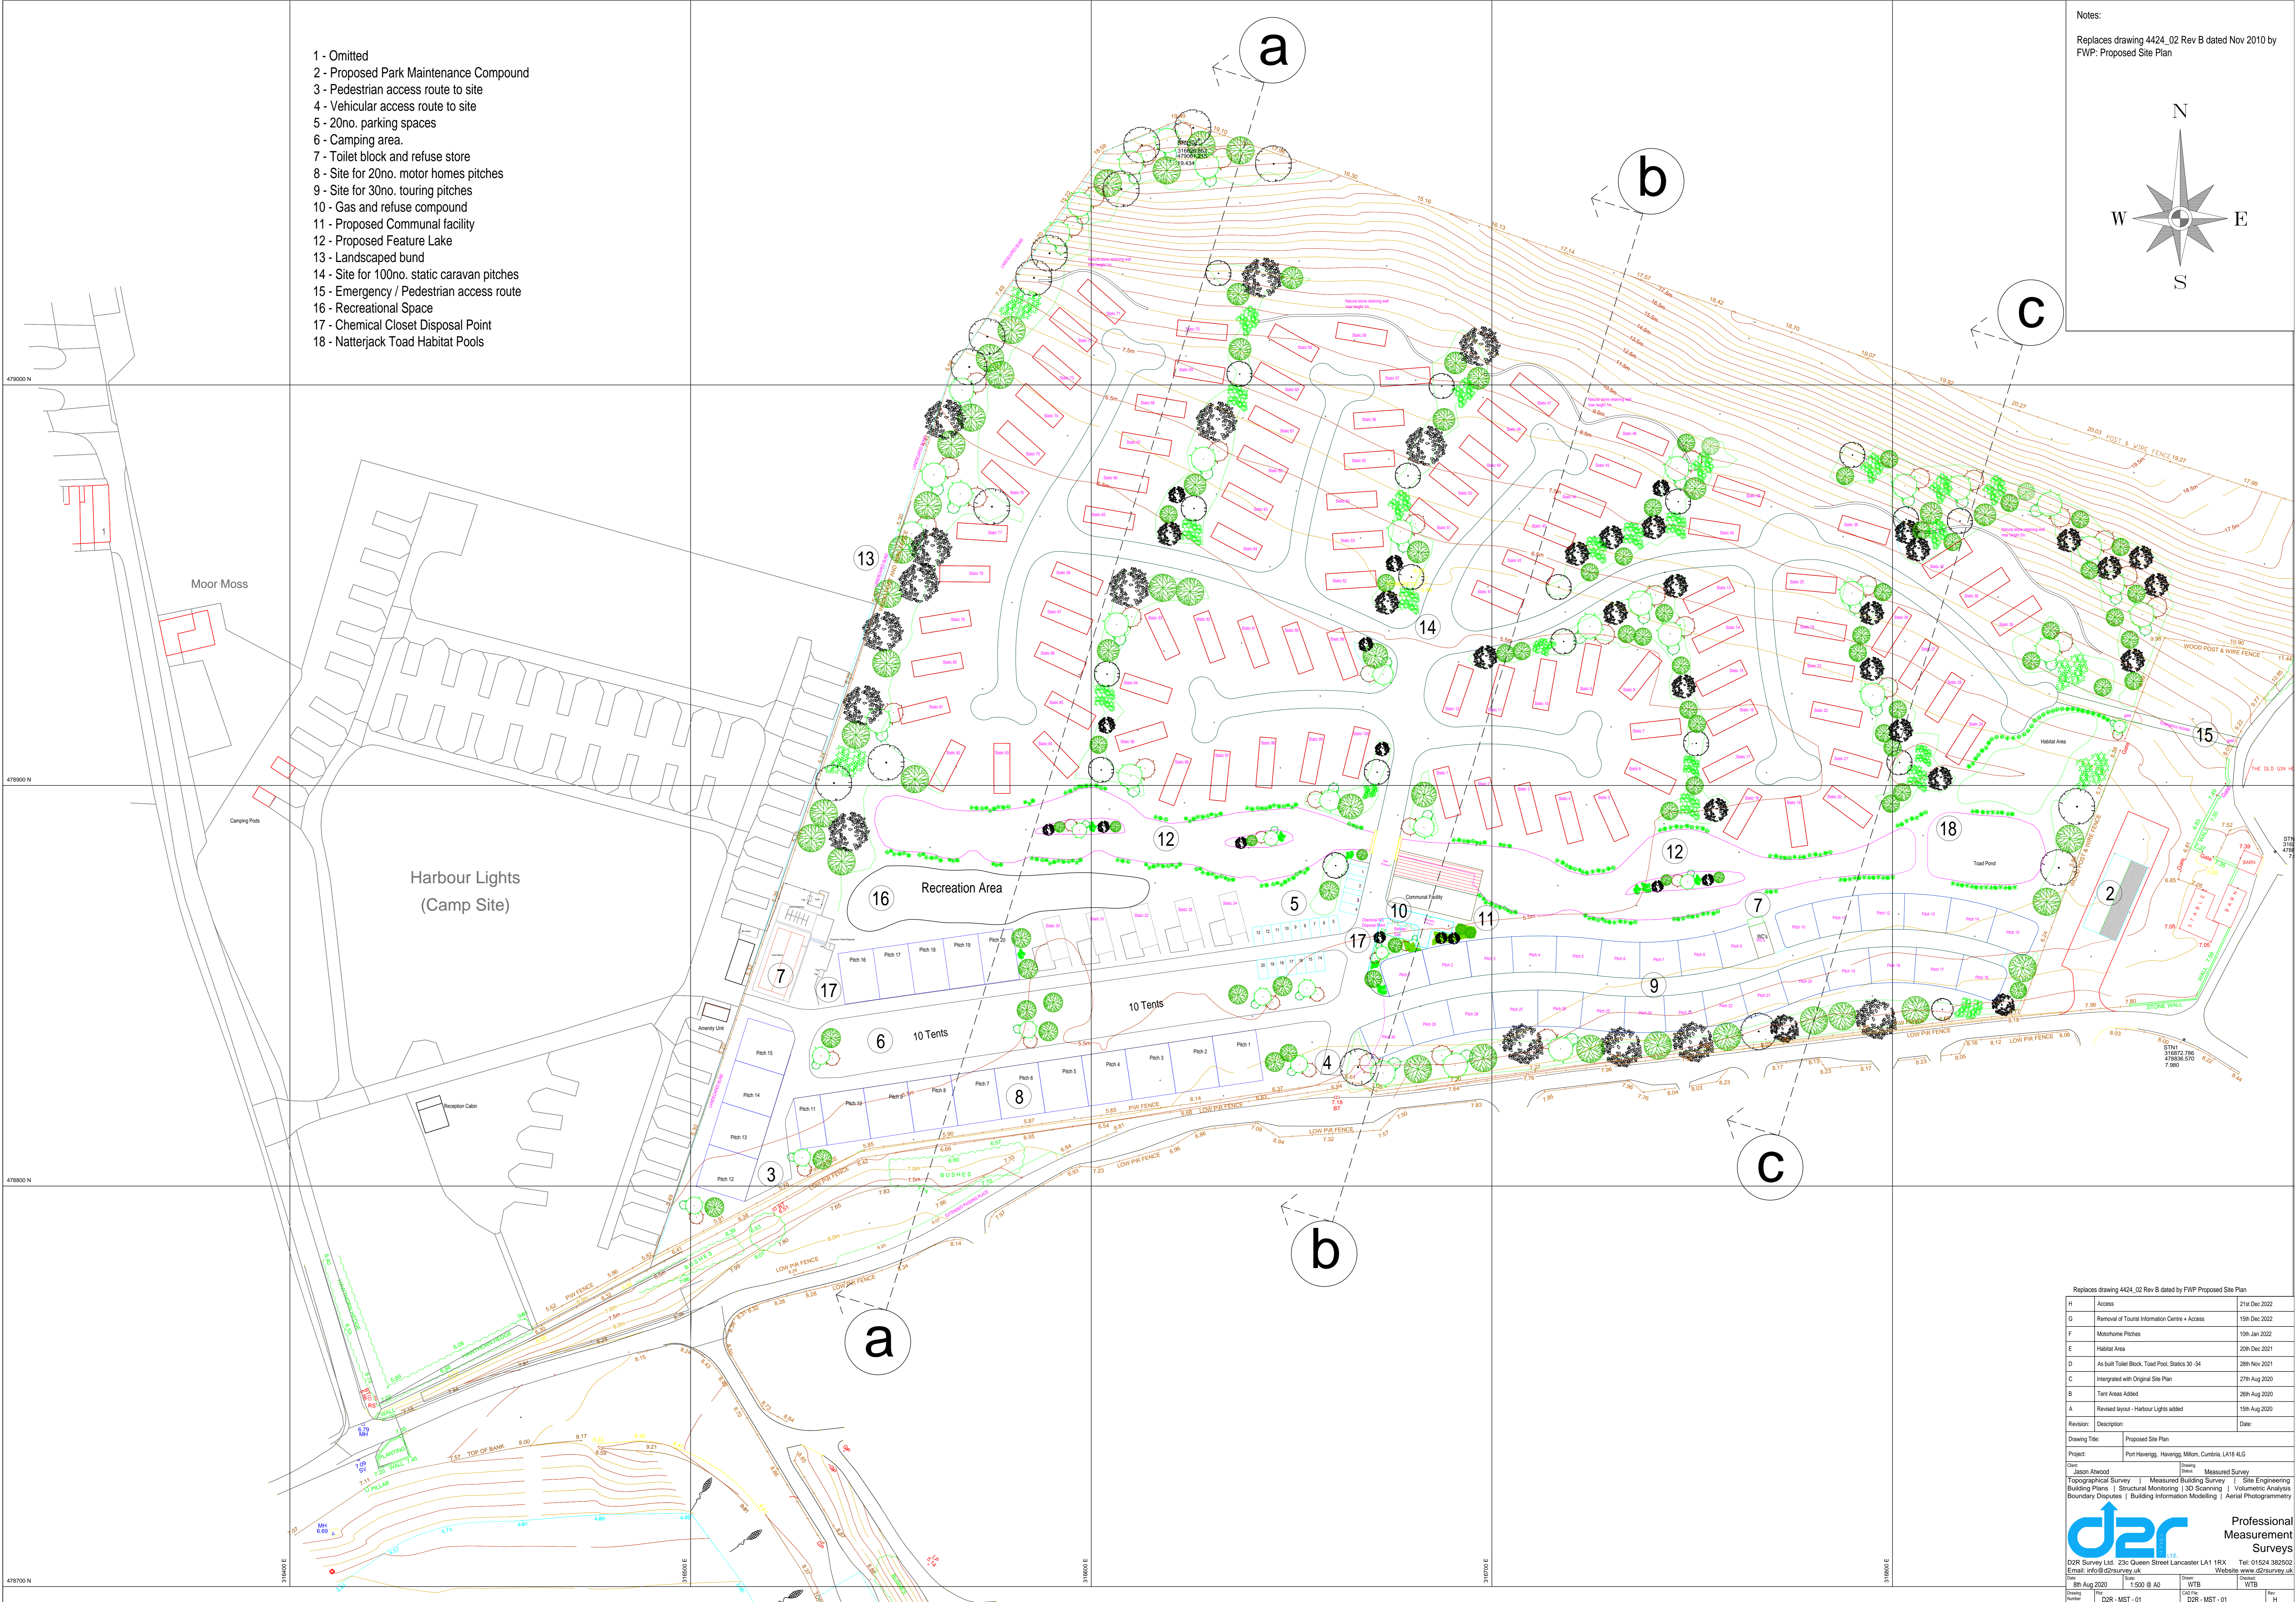


- 1 - Omitted
- 2 - Proposed Park Maintenance Compound
- 3 - Pedestrian access route to site
- 4 - Vehicular access route to site
- 5 - 20no. parking spaces
- 6 - Camping area.
- 7 - Toilet block and refuse store
- 8 - Site for 20no. motor homes pitches
- 9 - Site for 30no. touring pitches
- 10 - Gas and refuse compound
- 11 - Proposed Communal facility
- 12 - Proposed Feature Lake
- 13 - Landscaped bund
- 14 - Site for 100no. static caravan pitches
- 15 - Emergency / Pedestrian access route
- 16 - Recreational Space
- 17 - Chemical Closet Disposal Point
- 18 - Natterjack Toad Habitat Pools

Notes:
Replaces drawing 4424_02 Rev B dated Nov 2010 by
FWP: Proposed Site Plan

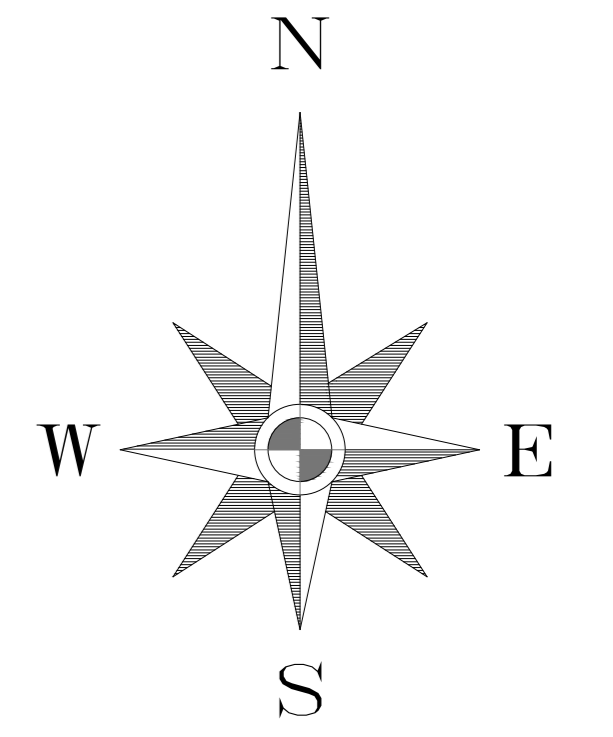

Replaces drawing 4424_02 Rev B dated by FWP Proposed Site Plan		
H	Access	21st Dec 2022
G	Removal of Tourist Information Centre + Access	15th Dec 2022
F	Motorhome Pitches	10th Jan 2022
E	Habitat Area	20th Dec 2021
D	As built Toilet Block, Toad Pond, Statics 30 - 34	28th Nov 2021
C	Integrated with Original Site Plan	27th Aug 2020
B	Tent Areas Added	26th Aug 2020
A	Revised layout - Harbour Lights added	15th Aug 2020
Revision:	Description:	Date:
Drawing Title:	Proposed Site Plan	
Project:	Port Haverigg - Haverigg Millon, Cumbria, LA18 4LG	
Client:	Jason Atwood	Survey: Measured Survey
D2R Survey Ltd. 23c Queen Street Lancaster LA1 1RX Tel: 01524 382502 Email: info@d2rsurvey.co.uk Website: www.d2rsurvey.co.uk Services: Topographical Survey Measured Building Survey Site Engineering Building Plans Structural Monitoring 3D Scanning Volumetric Analysis Boundary Disputes Building Information Modelling Aerial Photogrammetry		
Date:	8th Aug 2020	Scale: 1:500 @ A0
Drawn:	WTB	Checked: WTB
Number:	D2R - MST - 01	Rev: H