




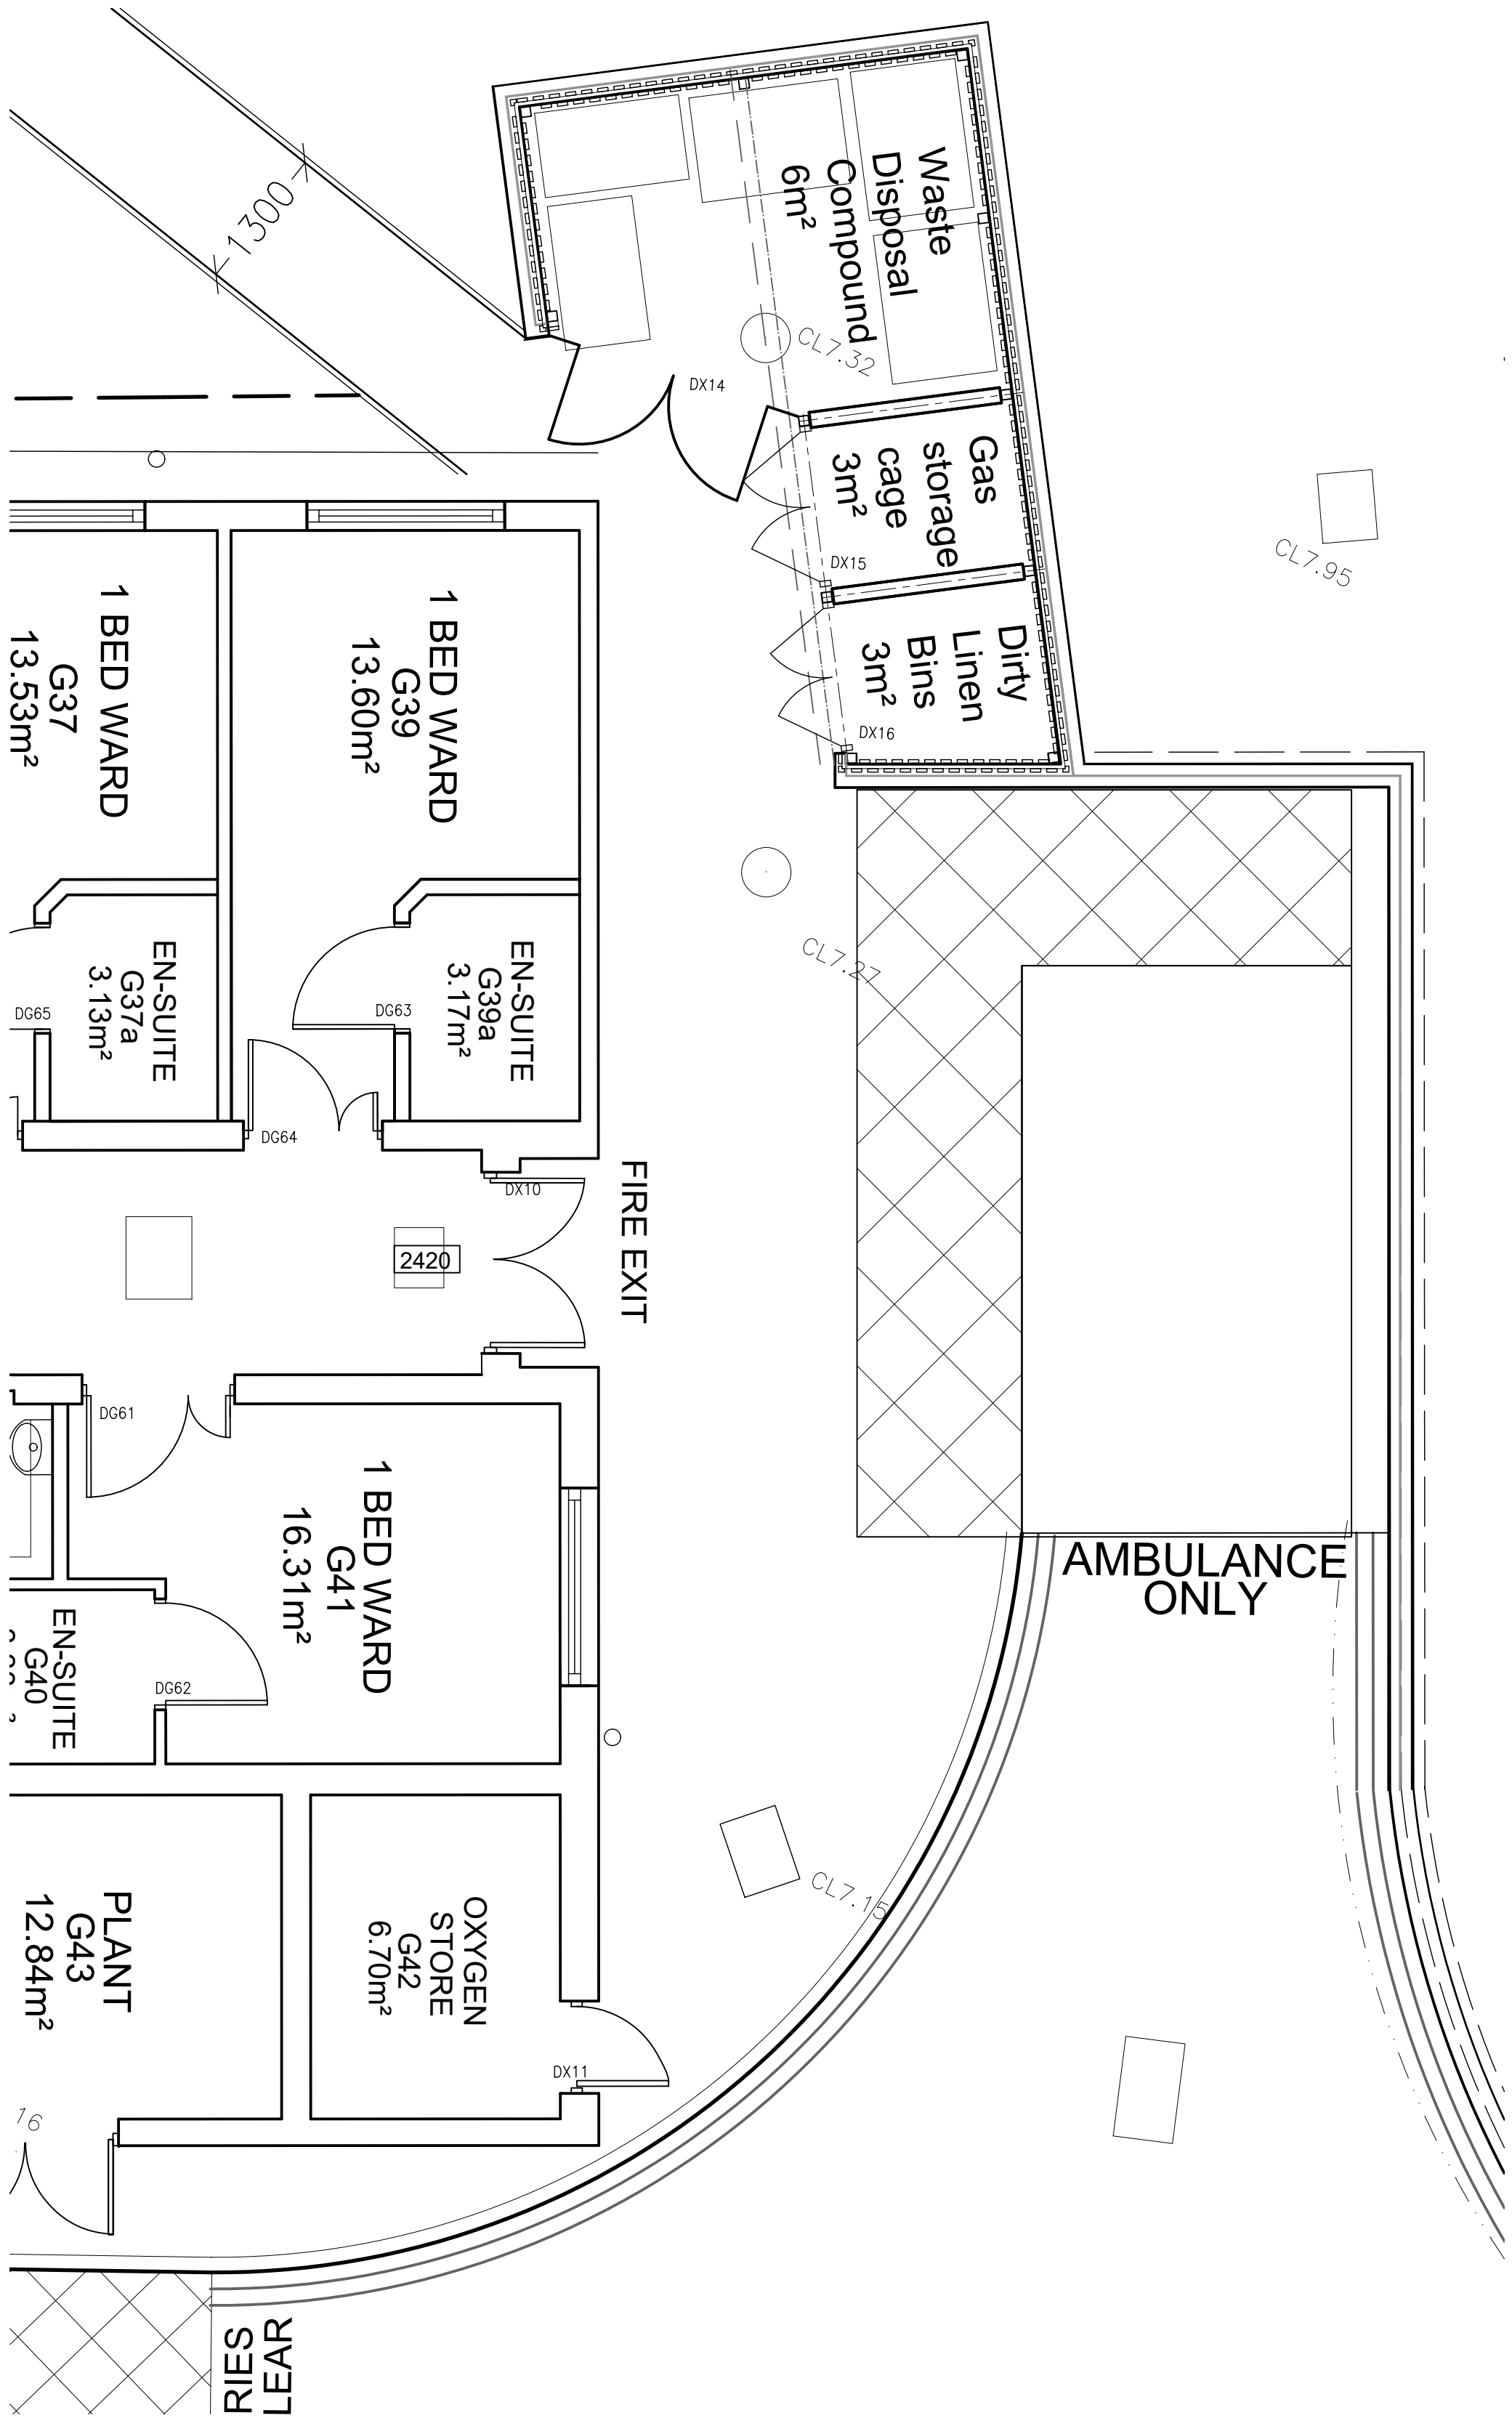

Existing Plan
1:50

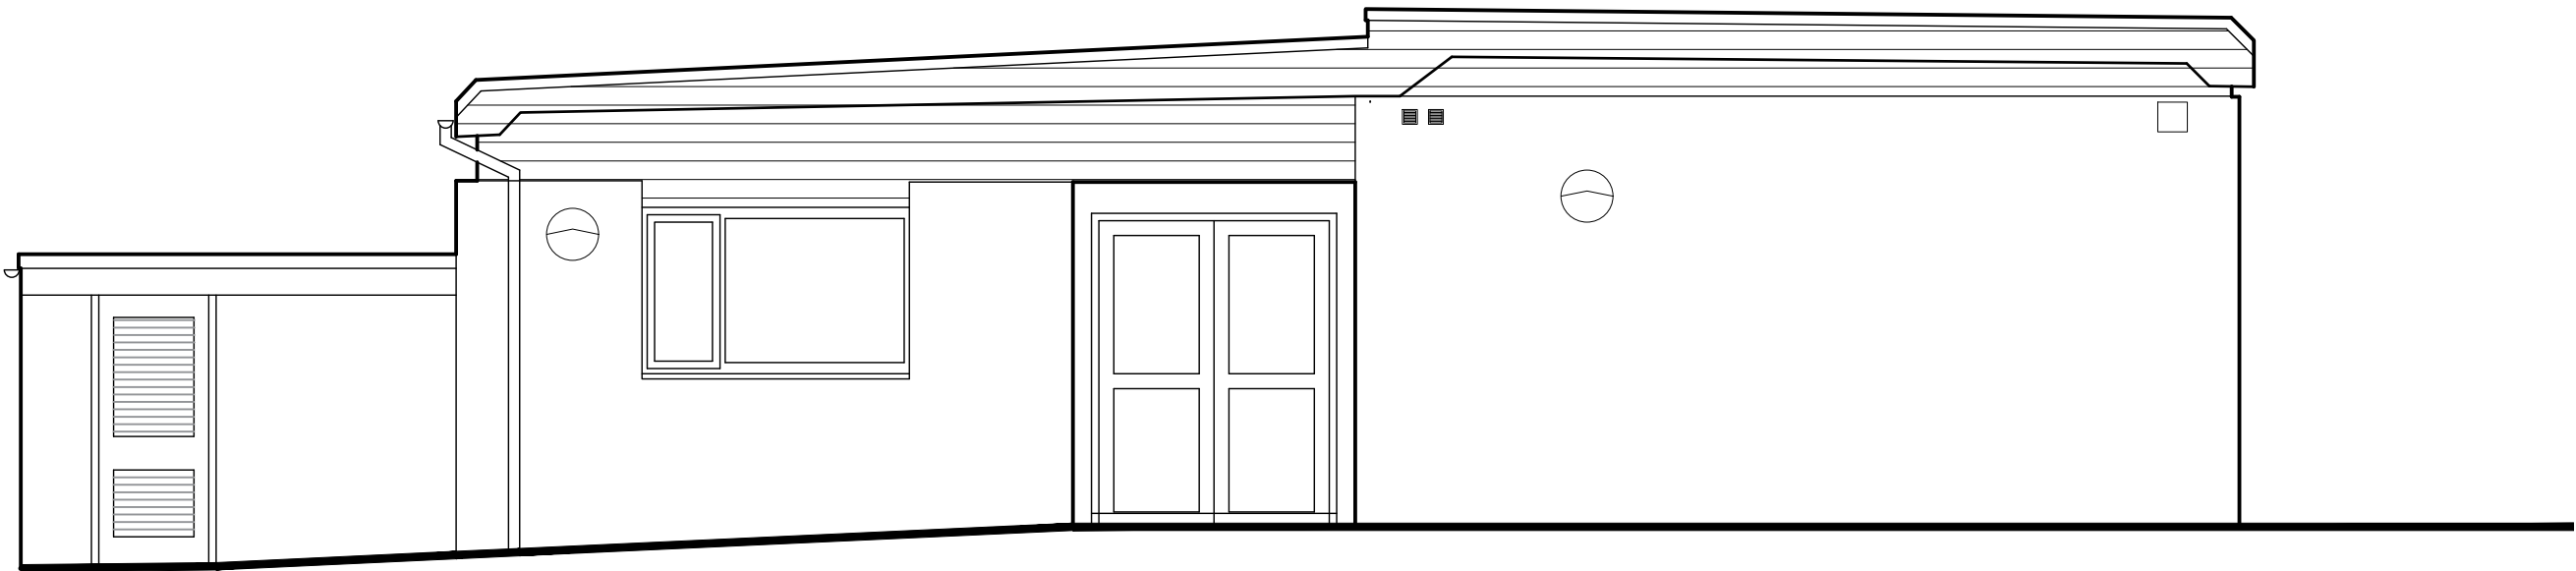

East Elevation
1:50

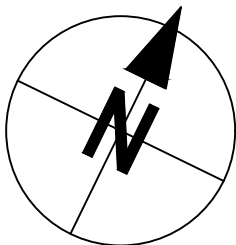

REV. DATE REVISION NOTE

THIS DRAWING AND ITS CONTENTS ARE AND REMAIN THE COPYRIGHT OF MELLOR ARCHITECTS LIMITED. DO NOT SCALE. IF IN DOUBT SEEK CLARIFICATION.

mellorarchitects

125 Highgate
Kendal
Cumbria LA9 4EN
T: 01539 727402
F: 01539 730181
kendal@mellorarchitects.com

1 Cable Court
Pittman Way
Fulwood, Preston PR2 9YW
T: 01772 797788
F: 01772 797780
preston@mellorarchitects.com
www.mellorarchitects.com

CLIENT
University Hospitals of Morcambe Bay
NHS Foundation Trust

PROJECT
**Millom Hospital Ward
Entrance Lobby**

DRAWING TITLE
Existing Plan and Elevation

DATE
Feb 21

DRAWN
AM

SCALE & A1
1:50

DRAWING NUMBER
K978-F-01

REV

☐ PRE-TENDER ISSUE	☐ CONSTRUCTION ISSUE
☐ TENDER ISSUE	☒ AS-BUILT DRAWINGS