


proposed plan

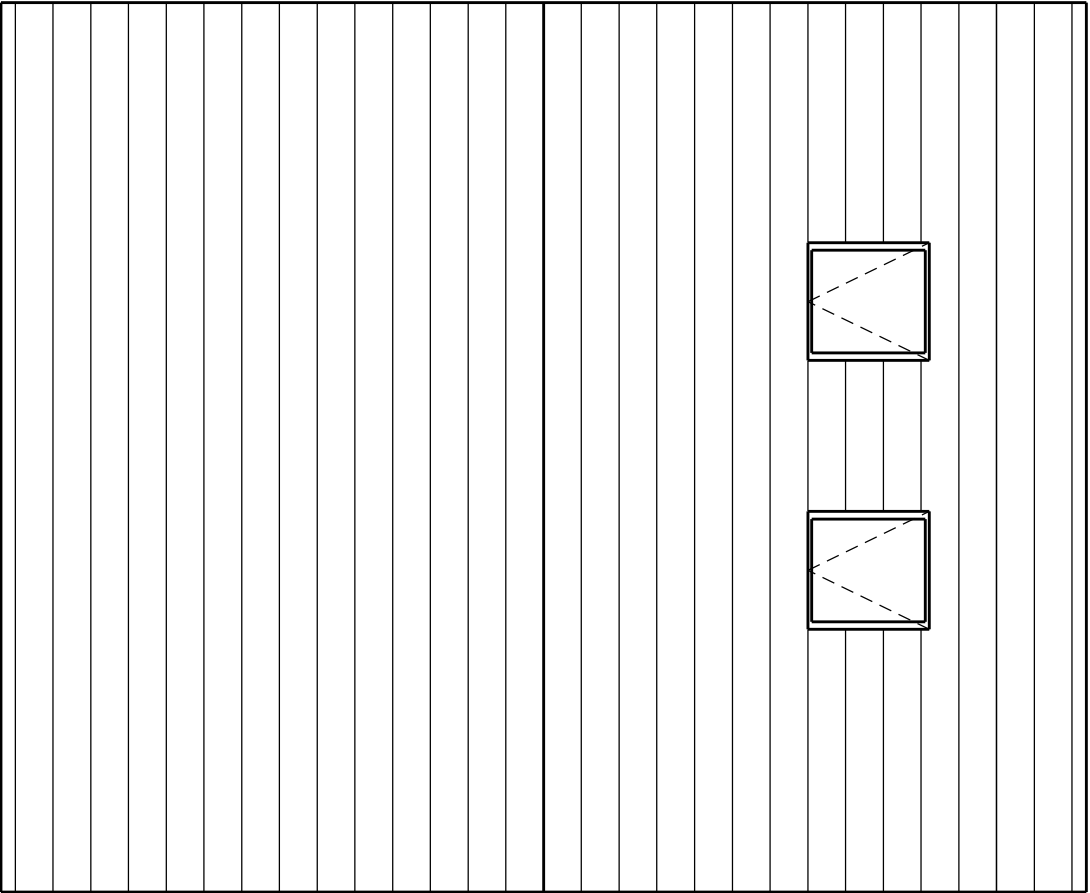

proposed roof plan

SCALE



This scheme is subject to town planning and all other necessary consents.

Dimensions, area and levels where given are only approximate and subject to site survey. All dimensions are to be checked on site. Any discrepancies or variations are to be reported to the client before work commences. Figured dimensions only are to be taken from this drawing.

This drawing is to be read in conjunction with all relevant consultants' and/or specialists drawings/documents and any discrepancies or variations are to be notified to the client before the affected work commences.

| | | |
|--------|----------|-----------------------|
| Rev 01 | sep 2021 | First issue |
| Rev 02 | jan 2022 | Building size reduced |
| Rev 03 | jan 2022 | Client amendment |
| Rev 04 | nov 2022 | Amended to as built |

| | |
|---------------|---|
| Client | Mr. L. Messenger |
| Job Title | Proposed garage for 1 Earls Road Bransty, Whitehaven |
| Drawing Title | Proposed plan and roof plan |

| | | |
|------------------|----------|------|
| Scale: 1:50 @ A3 | | |
| Date: | Drawn: | |
| sep 2021 | | |
| Job No: | Drwg No: | Rev: |
| 316 | 04001 | 04 |

Richard J Lindsay
Home Dale
Low Scales
Wigton
CA7 3NE

email: calvadesign46@gmail.com
Mob : 07921 949618