




80mm Ø Lateral (Perforated Plastic Pipe)

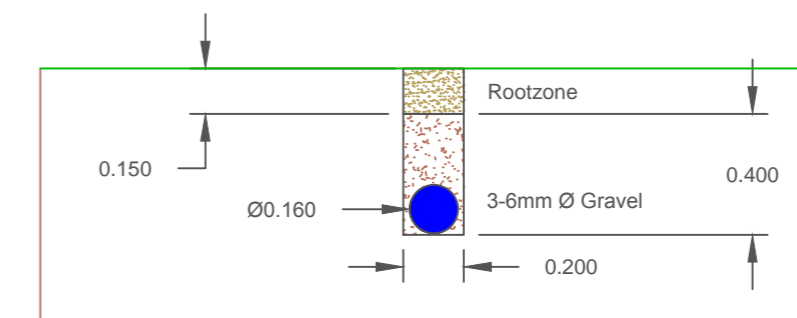

160mm Ø Collector (Perforated Plastic Pipe)

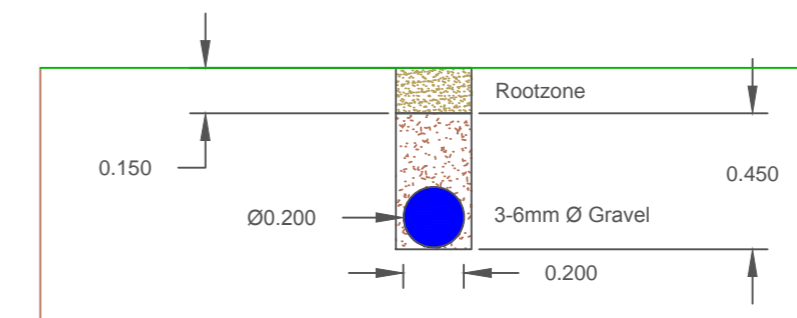

200mm Ø Collector (Perforated Plastic Pipe)

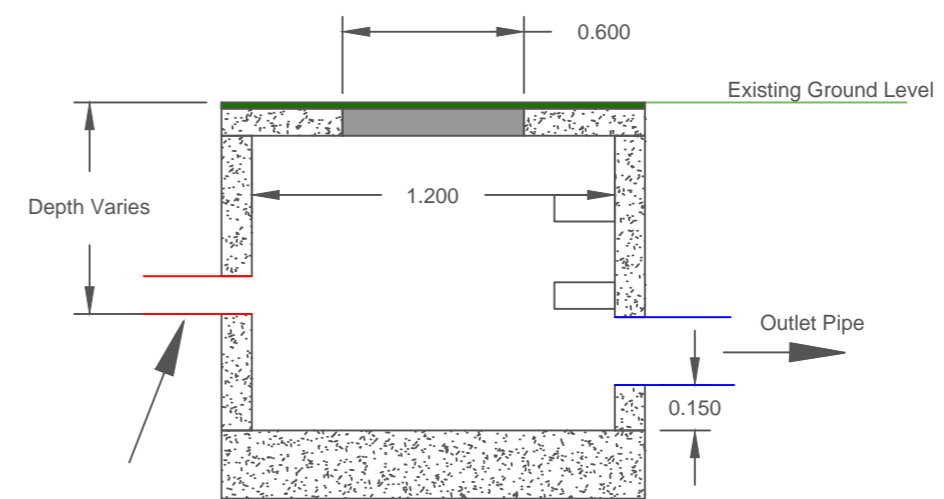

Generic Inspection Chamber Design

Scale 1:25 @ A2

NOTES:-

1) As Built drainage detail provided by J.R Elliott on 4 / 12 15

Revisions				
Rev	Date	Description	Drawn By	Checked By
1				

LEGEND:-

- Major Contours - 1m Intervals
- Minor Contours - 25cm Intervals
- 80mm Ø Laterals
- 160mm Ø Collector
- 200mm Ø Collector
- Inspection Chamber
- Sand Banding Areas

ISOQAR  
REGISTERED

UKAS  
MANAGEMENT  
SYSTEMS  
0026

TGMS  
Ltd.

Sports  
Surface  
Consultants

Certificate Number 11324  
ISO 9001

TGMS Ltd, Cranfield Innovation Centre, University Way, Cranfield, Bedfordshire, MK43 0BT  
Tel: 01234 756040 Web: www.tgms.co.uk Email: enquires@tgms.co.uk

Drawing Title		<p>NORTH INDICATES ONLY</p>
<h3>Drainage Design</h3>		
Project : Whitehaven Playground Association		
Client : Whitehaven Playground Association		
Consultant : Tim Colcough		
Date : 27/08/2014	Drawing Status : As Built	
Scale : 1:750	Paper Size : A2	
Drawn by : MP	Checked by : TC	
Drawing Number <h2>TGMS-0892.9-2</h2>		Revision <h2>0</h2>