

**GLAMPING POD
WITH COVERED
DECK**



+65.00 EXISTING GROUND LEVELS

27/01/22	Red line boundary amended per comments.	B	TA
17/01/22	Floor levels added per council request.	A	TA
Date	Description	Rev	By

LOCATION PLAN 1:7500

A location plan map at a scale of 1:7500. The map shows a green field with a grid overlay. A blue line outlines a long, narrow area, and a red line outlines a smaller area within it. A road or path runs along the right side of the blue area. A north arrow is located in the bottom right corner, pointing upwards and slightly to the right. The text 'LOCATION PLAN 1:7500' is at the top.


Drawing Title:
PROPOSED SITE PLAN

Revision:	B
Date:	11-10-21
Scale:	1:200 @ A1
Drawn By:	TA
CAD Dwg File:	
Checked By:	EC

Issue Status:	Full Planning Application
---------------	----------------------------------



SITE BOUNDARY

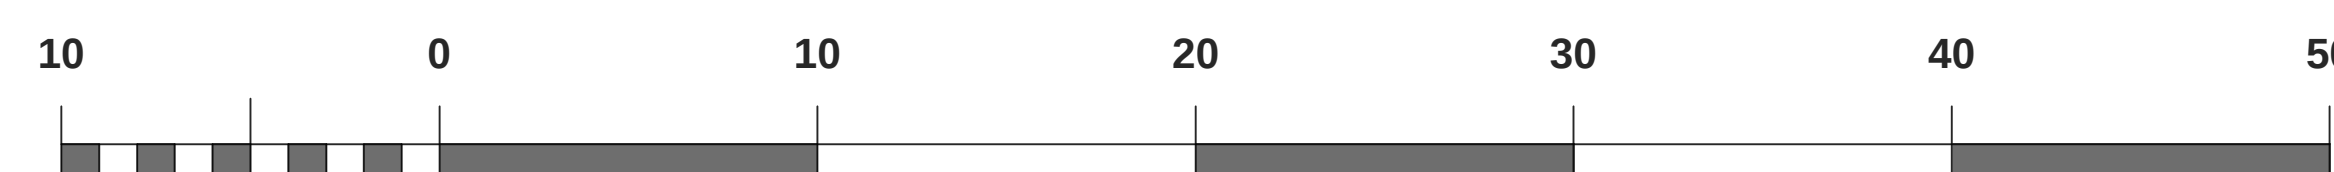

metres

