


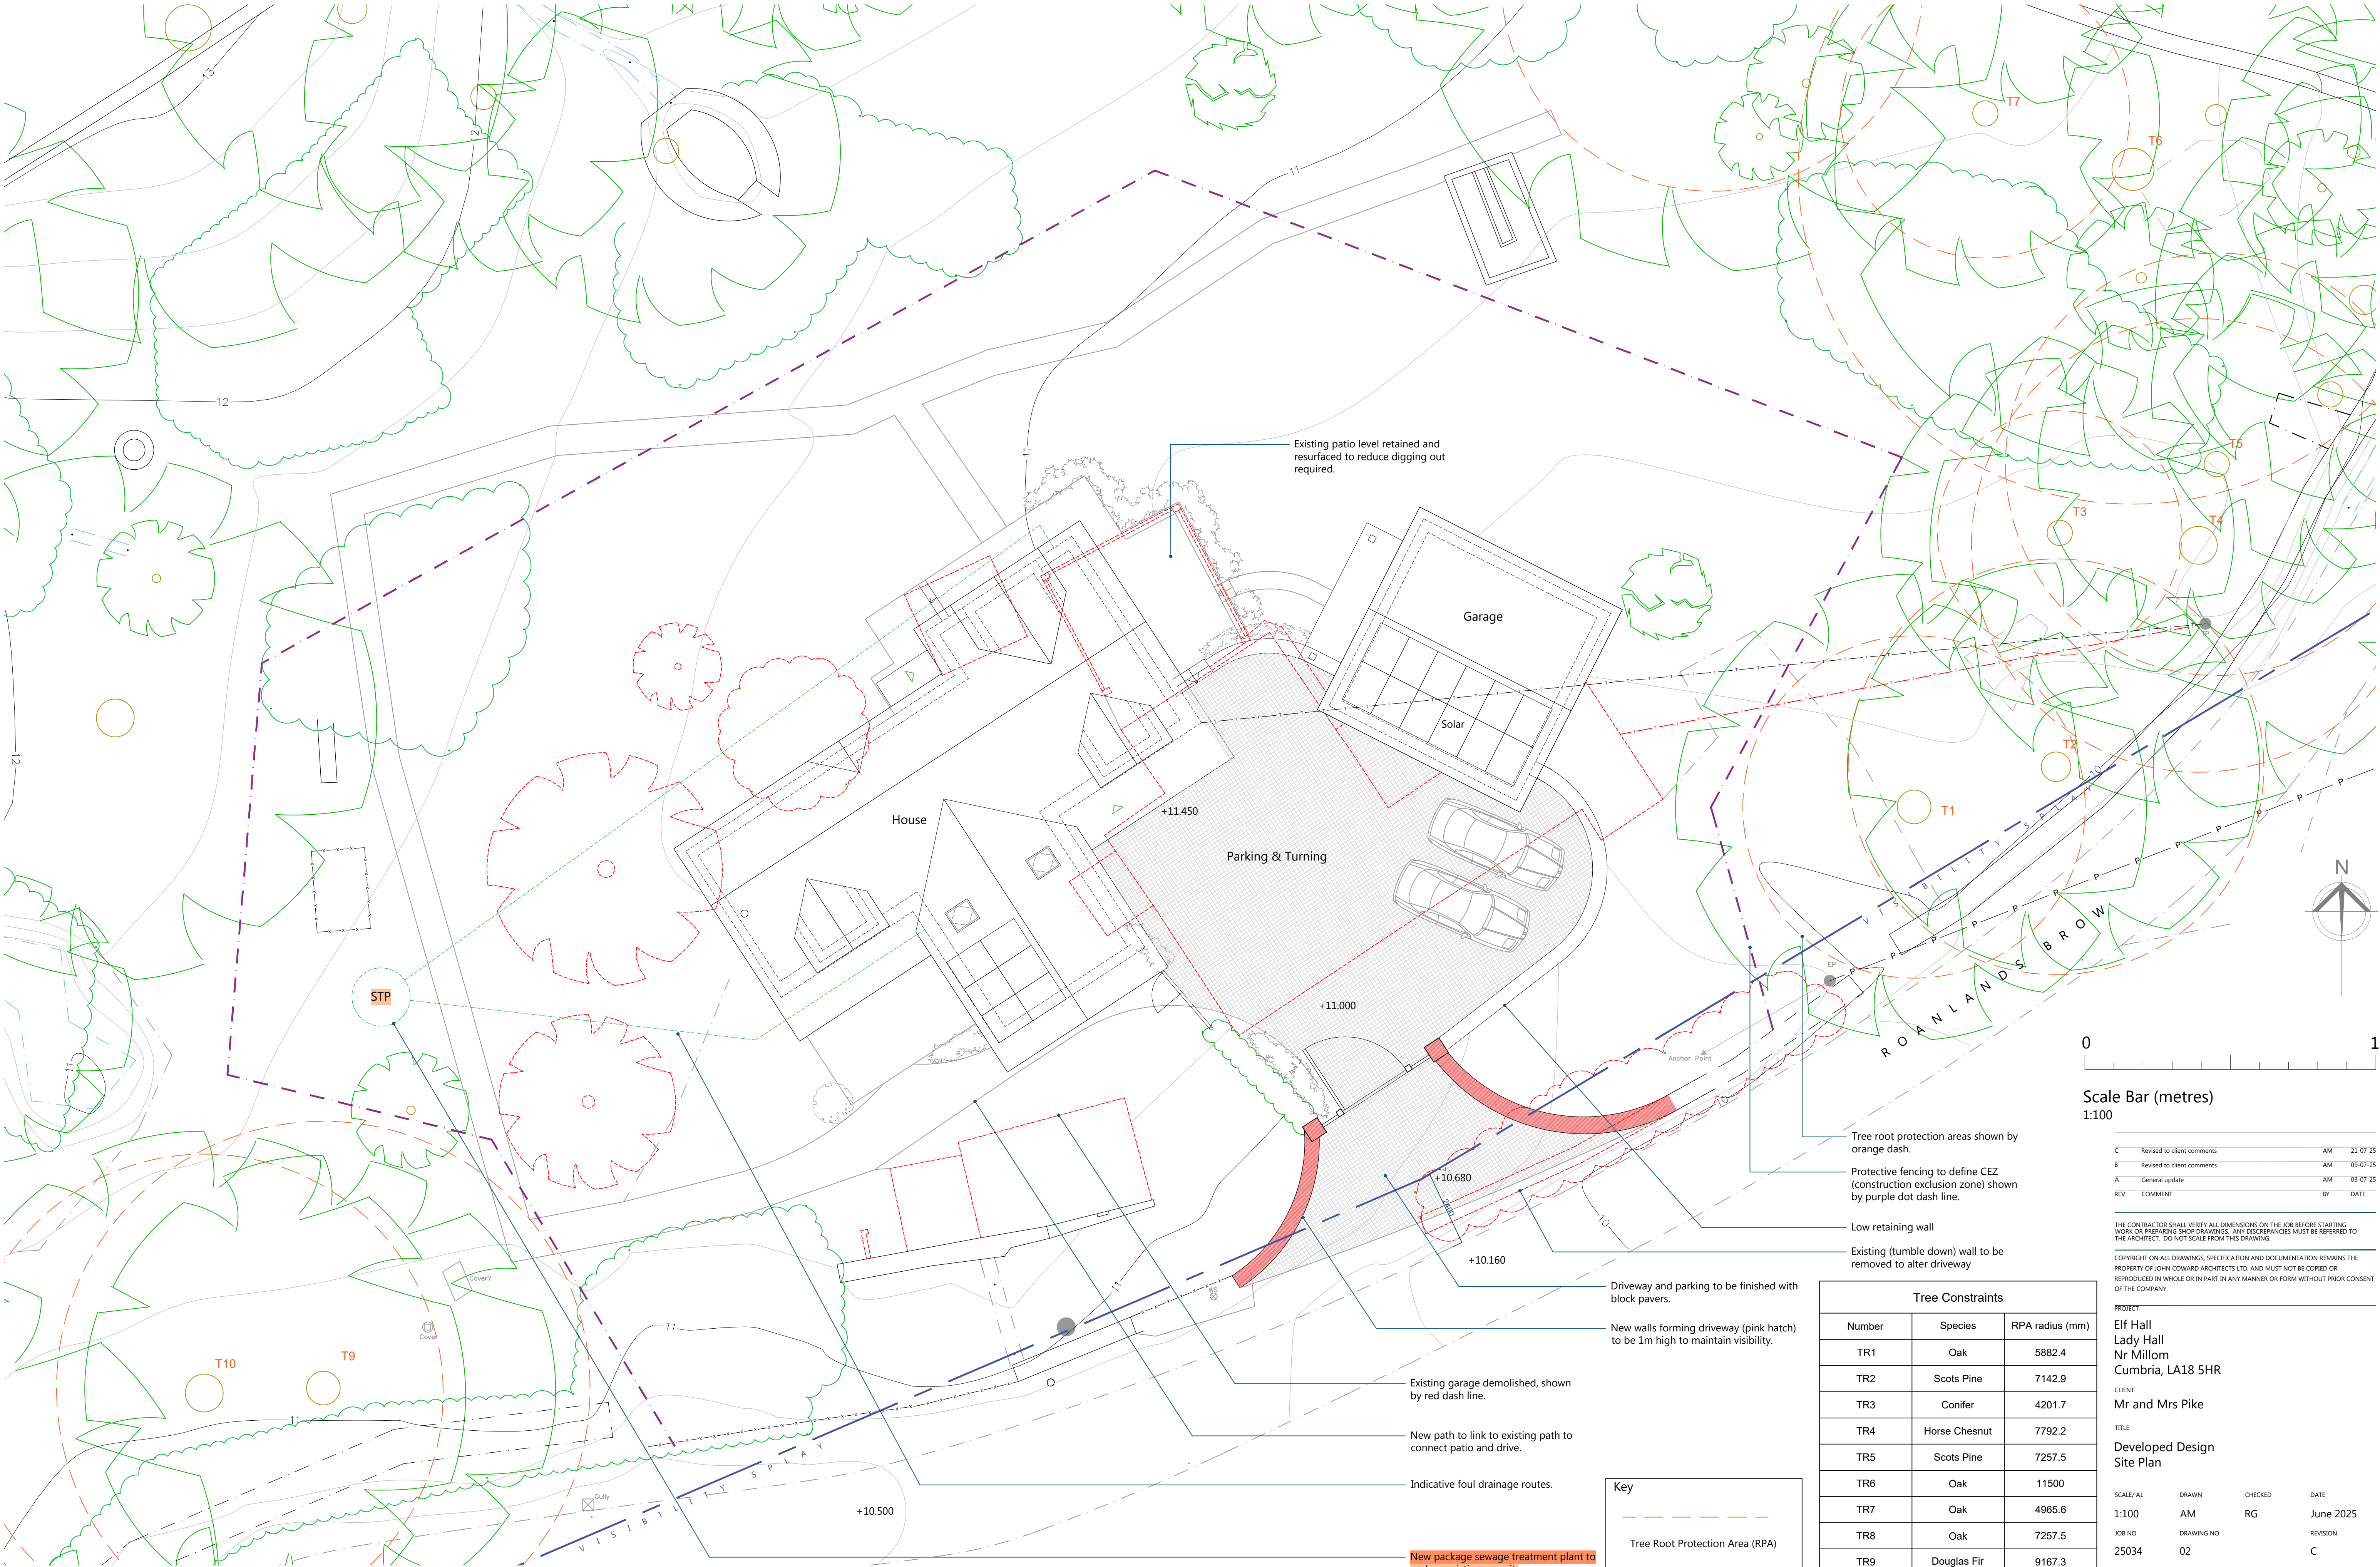


Site Plan
1:100

Key

- Tree Root Protection Area (RPA)
- Protective fencing to define CEZ (construction exclusion zone)

Tree Constraints		
Number	Species	RPA radius (mm)
TR1	Oak	5882.4
TR2	Scots Pine	7142.9
TR3	Conifer	4201.7
TR4	Horse Chesnut	7792.2
TR5	Scots Pine	7257.5
TR6	Oak	11500
TR7	Oak	4965.6
TR8	Oak	7257.5
TR9	Douglas Fir	9167.3
TR10	Douglas Fir	8212.4
TR11	Ash (with dieback to be felled)	

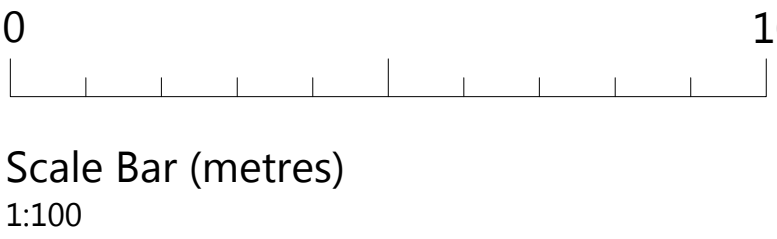

C	Revised to client comments	AM	21-07-25
B	Revised to client comments	AM	09-07-25
A	General update	AM	03-07-25
REV	COMMENT	BY	DATE

THE CONTRACTOR SHALL VERIFY ALL DIMENSIONS ON THE JOB BEFORE STARTING WORK OR PREPARING SHOP DRAWINGS. ANY DISCREPANCIES MUST BE REFERRED TO THE ARCHITECT. DO NOT SCALE FROM THIS DRAWING.

COPYRIGHT ON ALL DRAWINGS, SPECIFICATION AND DOCUMENTATION REMAINS THE PROPERTY OF JOHN COWARD ARCHITECTS LTD. AND MUST NOT BE COPIED OR REPRODUCED IN WHOLE OR IN PART IN ANY MANNER OR FORM WITHOUT PRIOR CONSENT OF THE COMPANY.

PROJECT	Elf Hall Lady Hall Nr Millom Cumbria, LA18 5HR		
CLIENT	Mr and Mrs Pike		
TITLE	Developed Design Site Plan		
SCALE/ A1	DRAWN	CHECKED	DATE
1:100	AM	RG	June 2025
JOB NO	DRAWING NO	REVISION	
25034	02	C	

jca
architects

JOHN COWARD ARCHITECTS LIMITED
No. 3 Unsworth's Yard,
Ford Road,
Cartmel,
Cumbria, LA11 6PG
Tel : (015395) 36596
www.johncowardarchitects.co.uk